


T.6 S. R.1 E.W.M.

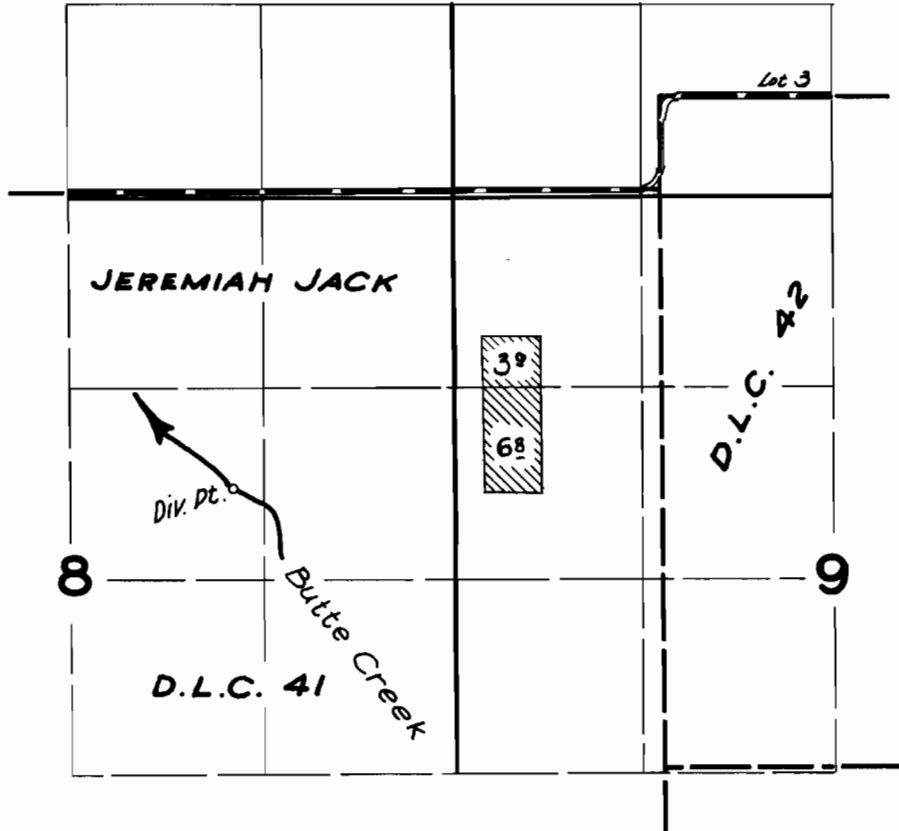

FINAL PROOF SURVEY
UNDER

Application No. 30492. Permit No. 24015.
IN NAME OF

ALBERT BARTH

Surveyed 29 Aug. 1958, by M. Bish

RF