


T. 10S. R. 2W. W.M.

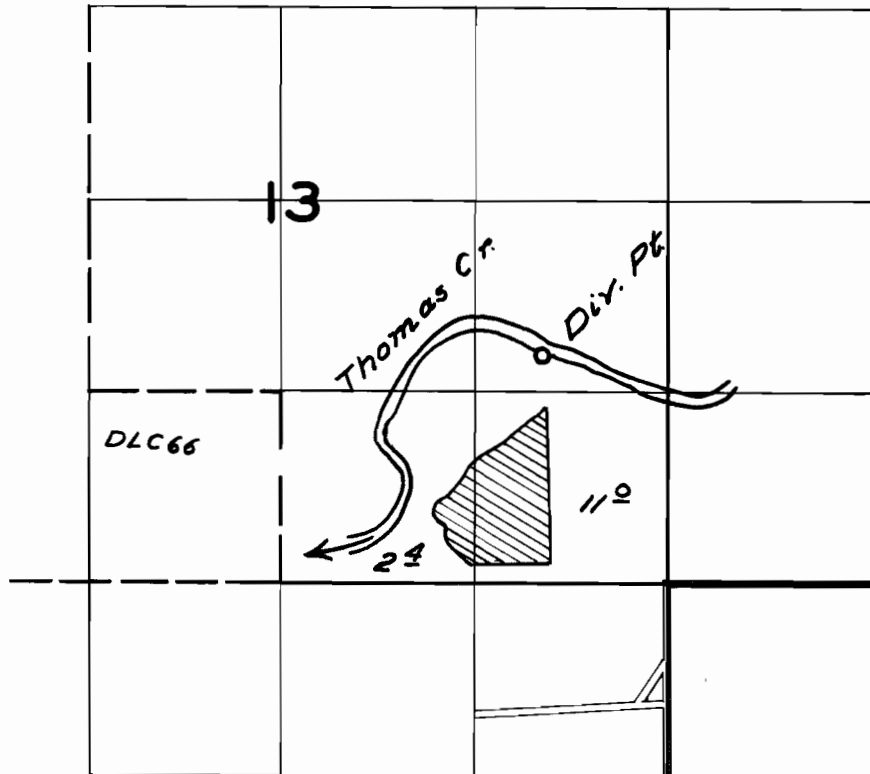

FINAL PROOF SURVEY
UNDER

Application No. 30537 Permit No. 24044
IN NAME OF

I. G. Faltus

Surveyed Sept. 5, 1958, by W. N. Perry