


T.3N.R.27-28E.W.M.

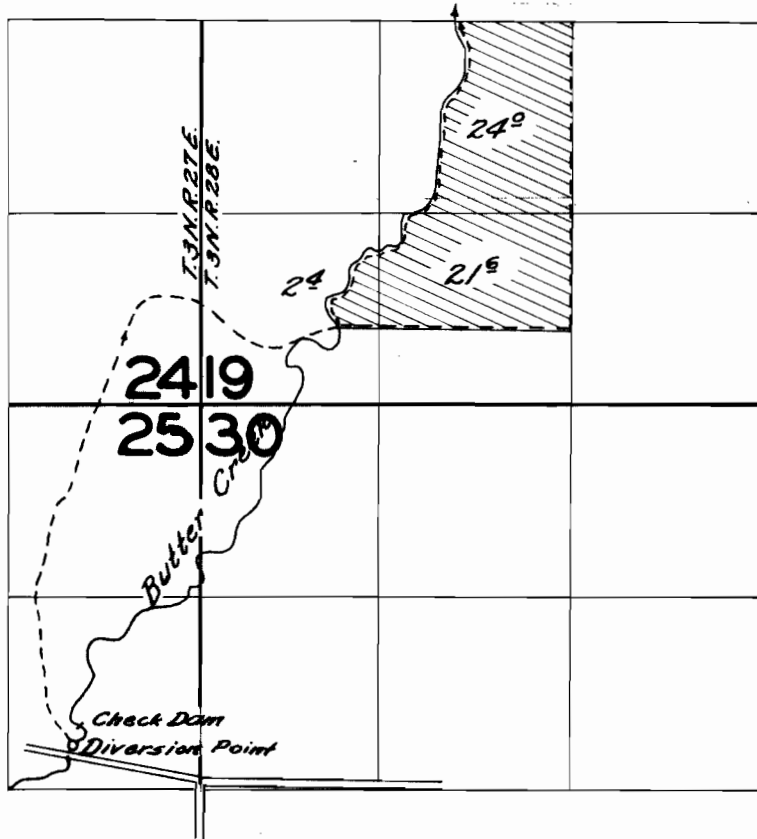

**FINAL PROOF SURVEY**  
UNDER

Application No. 30656.. Permit No. 24146.  
IN NAME OF

..... *R.G. Saylor* .....

Surveyed *Nov. 15, 1958*, by *M. Bish*.....