


T. IN. R. 3 W. W.M.

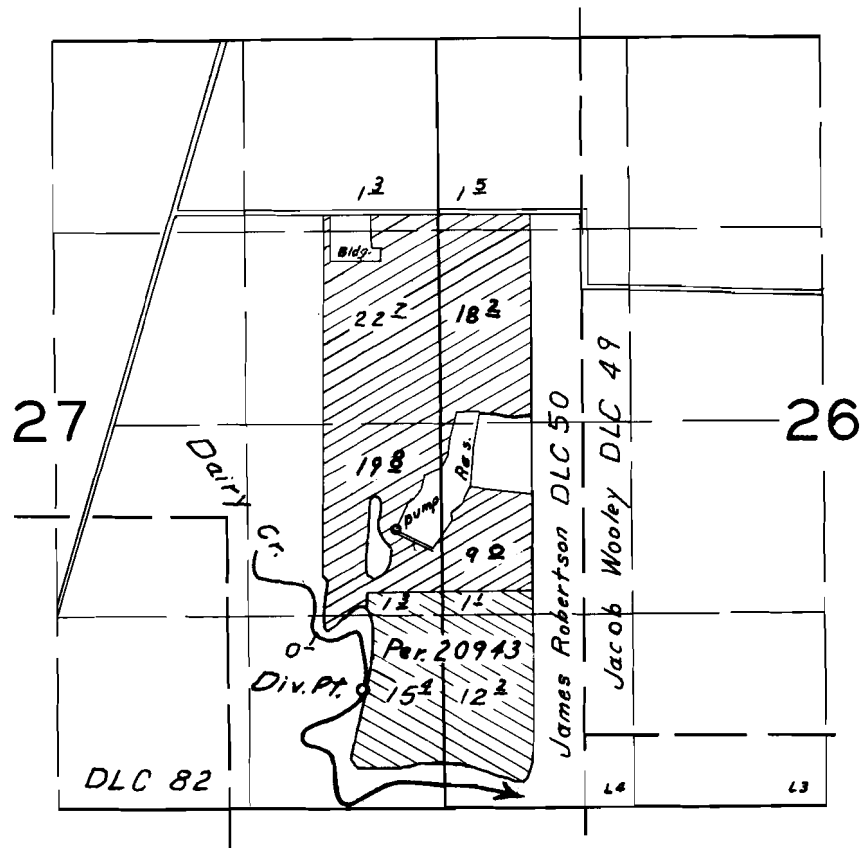

FINAL PROOF SURVEY
UNDER

R-30182 *R-1854*
Application No. *30183* Permit No. *24161*
IN NAME OF

Bernard Seus

Surveyed *April 28* 1958, by *R.H. Whitby*