


T.29 S.R.12 W.W.M.

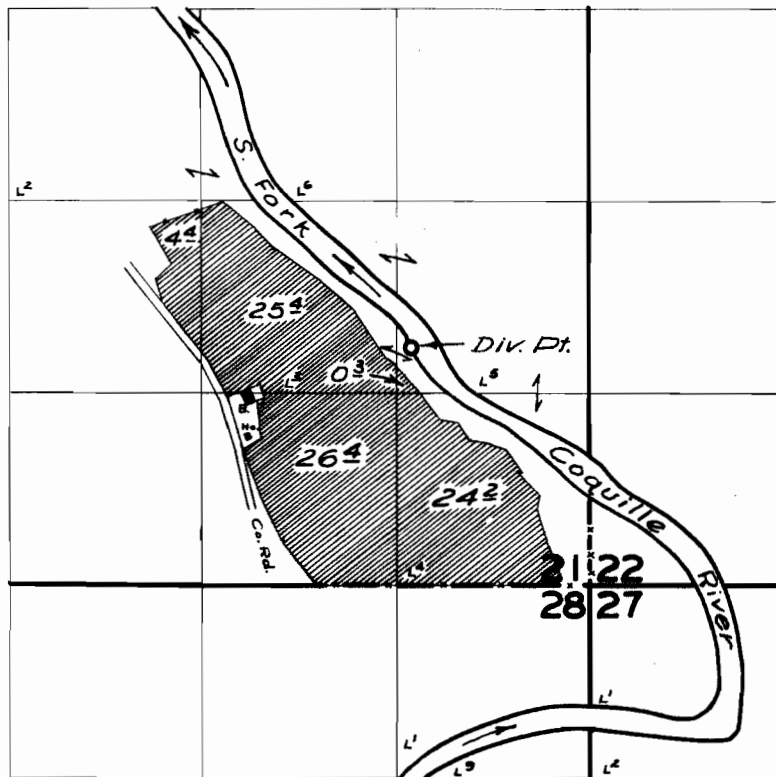

FINAL PROOF SURVEY UNDER

Application No. 30759 Permit No. 24230
IN NAME OF

G. D. Hall

Surveyed *8 July* 1958, by *Tom Bish*