


T. 5S. R. 3W. W.M.

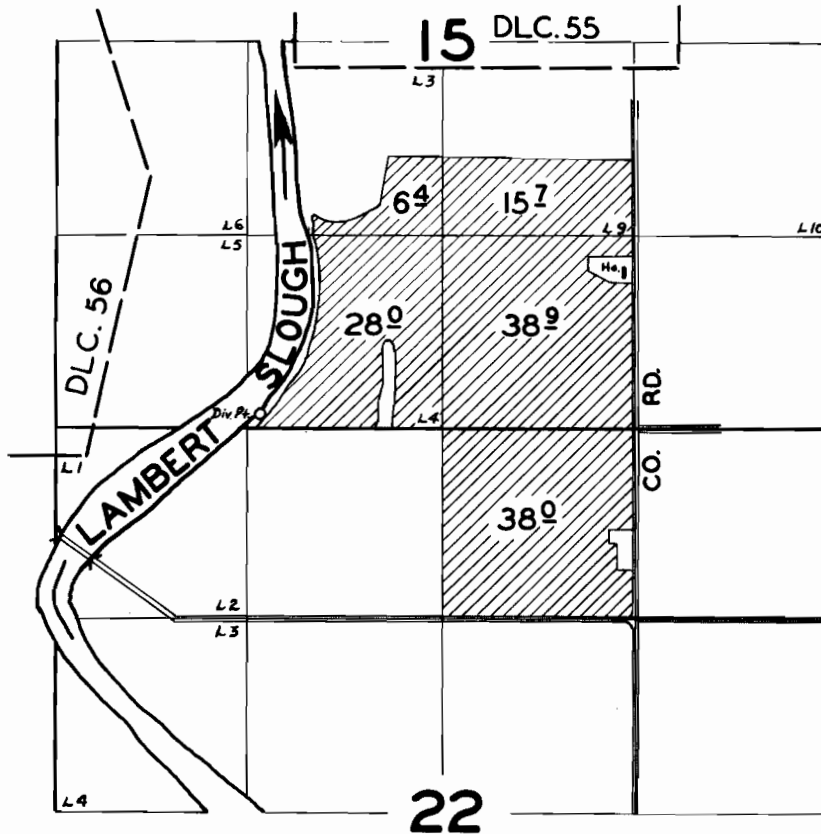

FINAL PROOF SURVEY
UNDER

Application No. **30941** Permit No. **24374**
IN NAME OF

DICK ROCKHILL

Surveyed **APR. 2** 1958, by *m. Bish*