


T.3S. R.3W.W.M.

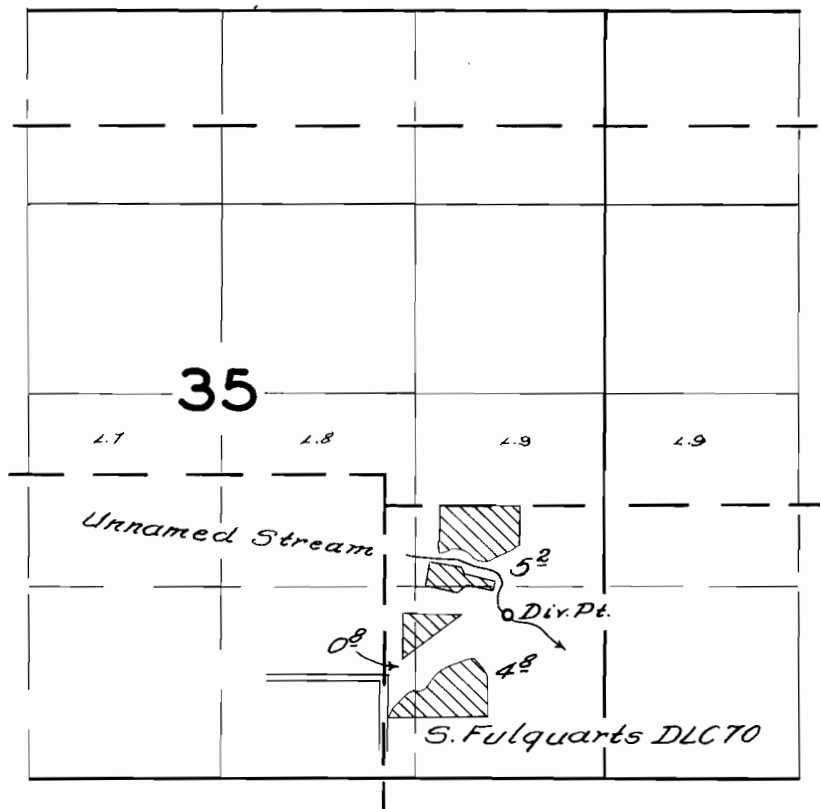

FINAL PROOF SURVEY
UNDER

Application No. *31020* ... Permit No. *24392* ...
IN NAME OF

H. H. HORTON

Surveyed *May 15 1958*, by *M. B. Bishop* ...