


# T. 13S. R. 32E. W.M.

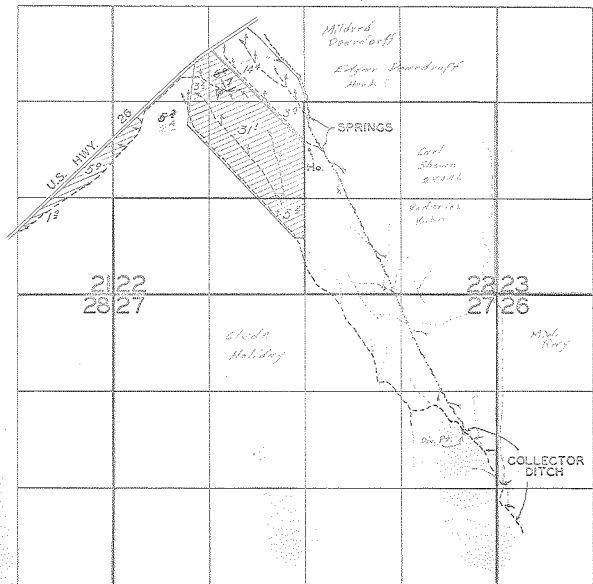

## FINAL PROOF SURVEY UNDER

Application No. 30849 Permit No. 24438  
IN NAME OF

MILDRED CAMPBELL DEARDORFF

Surveyed JUN. 20, 1957, by *Edgar Deardorff*