


T. 3N. R. 29E. W.M.

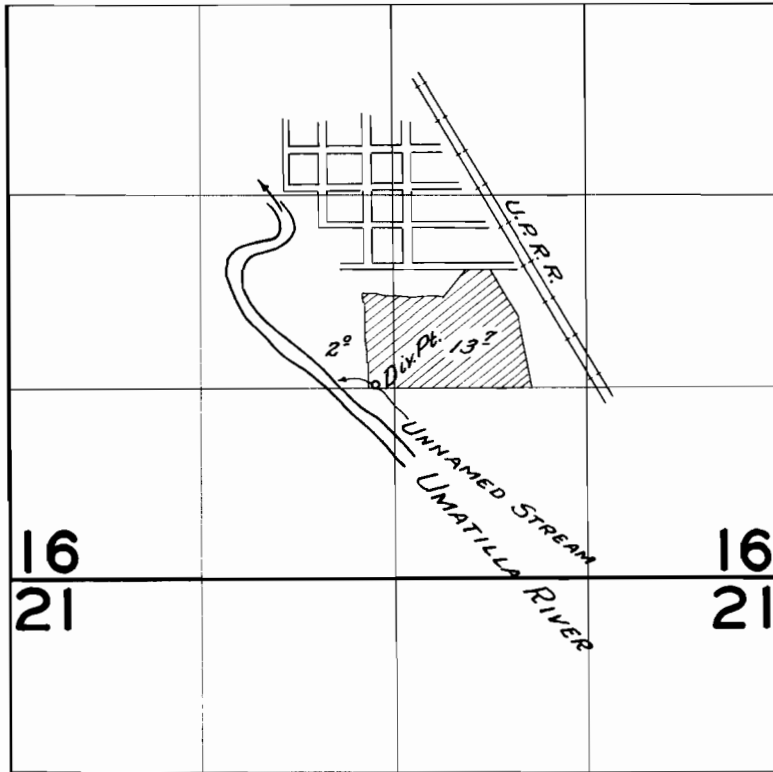

**FINAL PROOF SURVEY**  
UNDER

Application No. *31110* Permit No. *24516*  
IN NAME OF

*C.F. Grossmiller*

Surveyed *Nov. 15* 1958, by *M. Bisk*