


T. 4S. R. 3W. W.M.

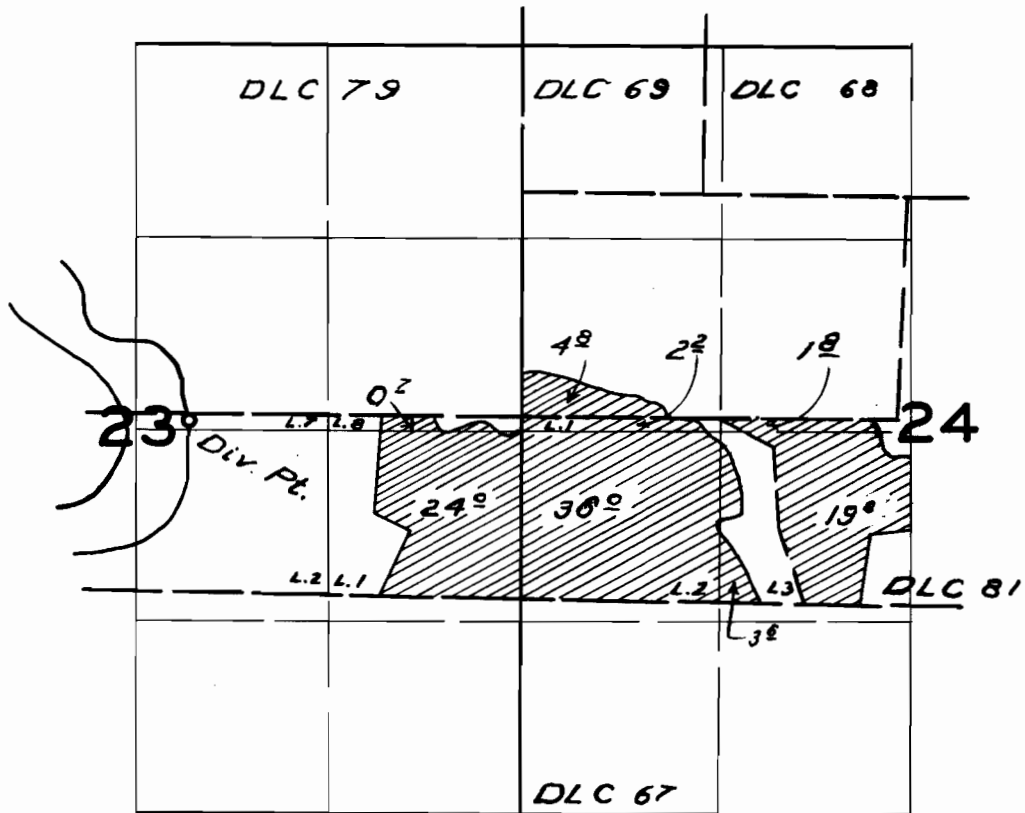

FINAL PROOF SURVEY
UNDER

Application No. 31284... Permit No. 24642
IN NAME OF

Norman Ernst

Surveyed June 27 1958, by *M. Bish*