


T.2N.R.16E.W.M.

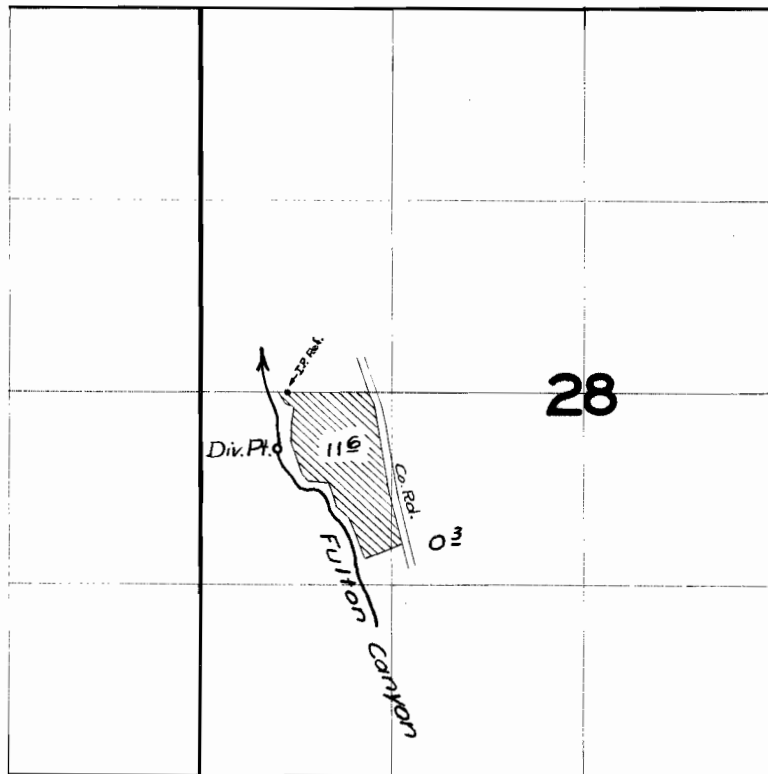

FINAL PROOF SURVEY
UNDER

Application No. 31415 Permit No. 24760
IN NAME OF

LOUIS SCHOLL

Surveyed 31 Oct. 1958, by M. B. Bish