


T.2 N.R.4 W.W.M.

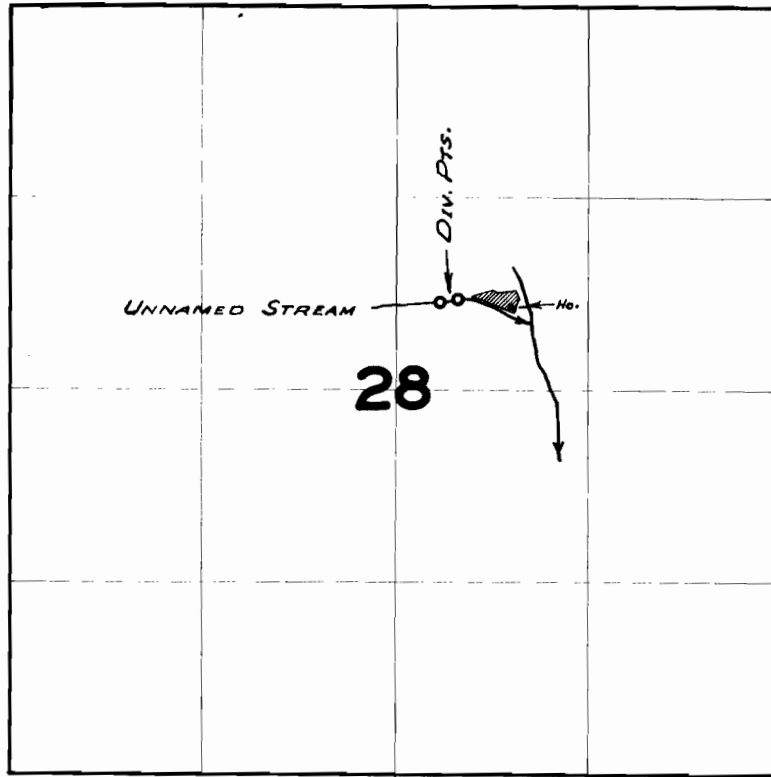

FINAL PROOF SURVEY UNDER

Application No. 31557 Permit No. 25073
IN NAME OF

KATE EBERLY

Surveyed 1 JULY 1958, by M. Bish