


T.2 N.R.4 W.W.M.

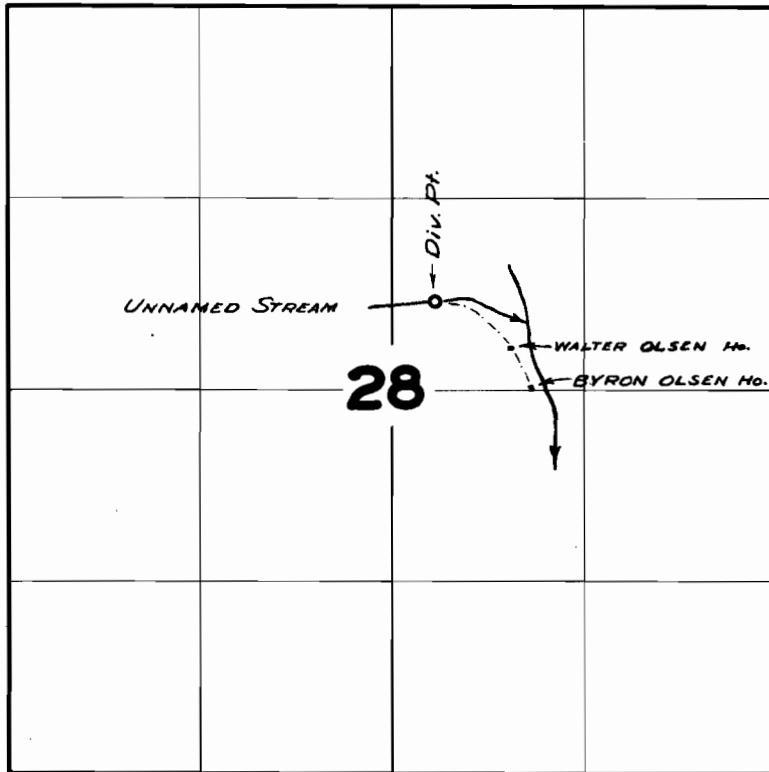

FINAL PROOF SURVEY
UNDER

Application No. 32038 Permit No. 25270
IN NAME OF

Walter A. & Mabel Olsen & Byron Ross Olson & Mrs. Byron R. Olson

Surveyed 1 July 1958, by M. Beech