


T.2S.R.3W.W.M.

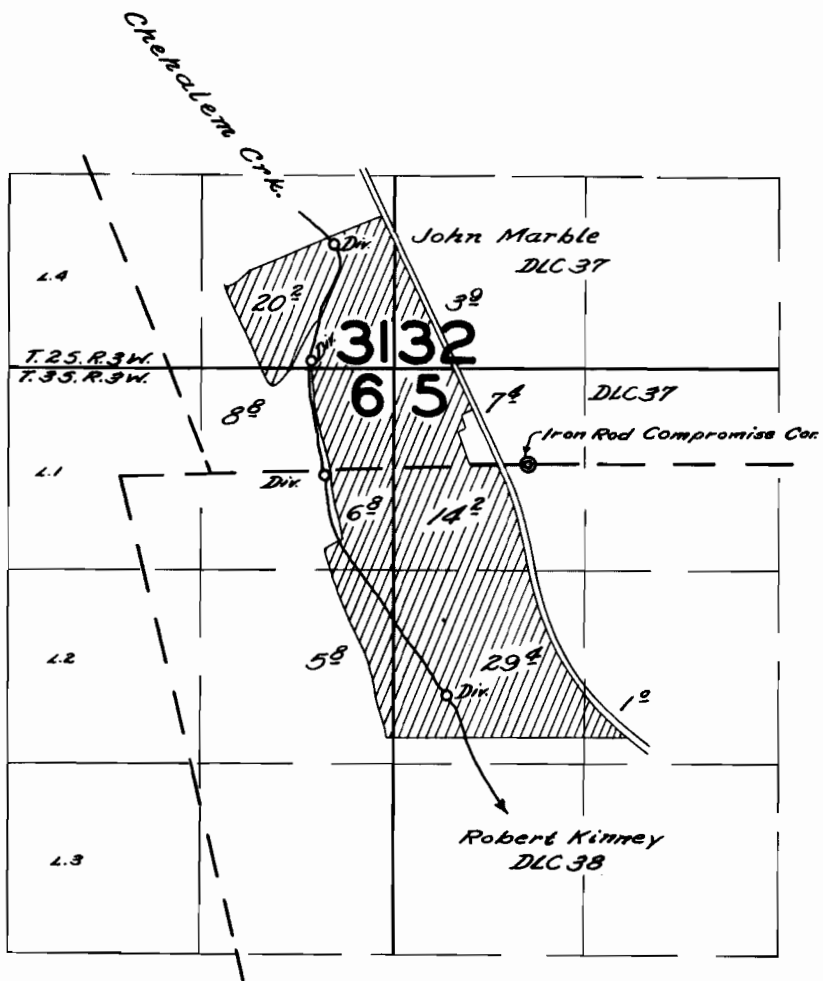

FINAL PROOF SURVEY UNDER

Application No. *32083* Permit No. *25327*
IN NAME OF

E. R. Baker

Surveyed *June 5, 1958*, by *M. Bish*