


T.4 N.27 E.W.M.

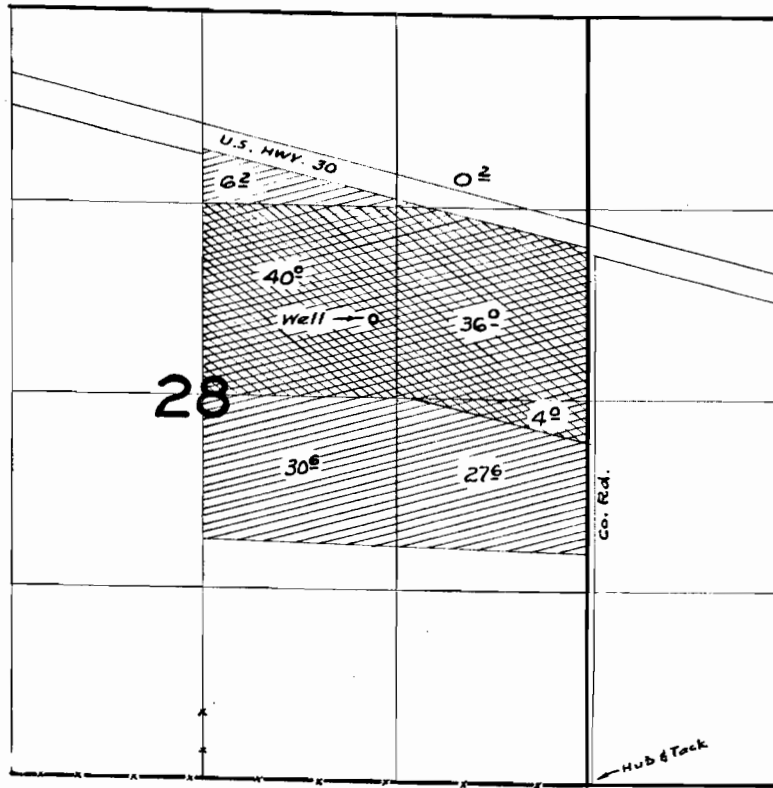

FINAL PROOF SURVEY UNDER

Application No. G-139 Permit No. G-100
U-545 U-498
IN NAME OF

SYLVANUS F. HOYT

Surveyed 15 Oct. 1958, by W. Bieh