


T.14S. R.39E.W.M.

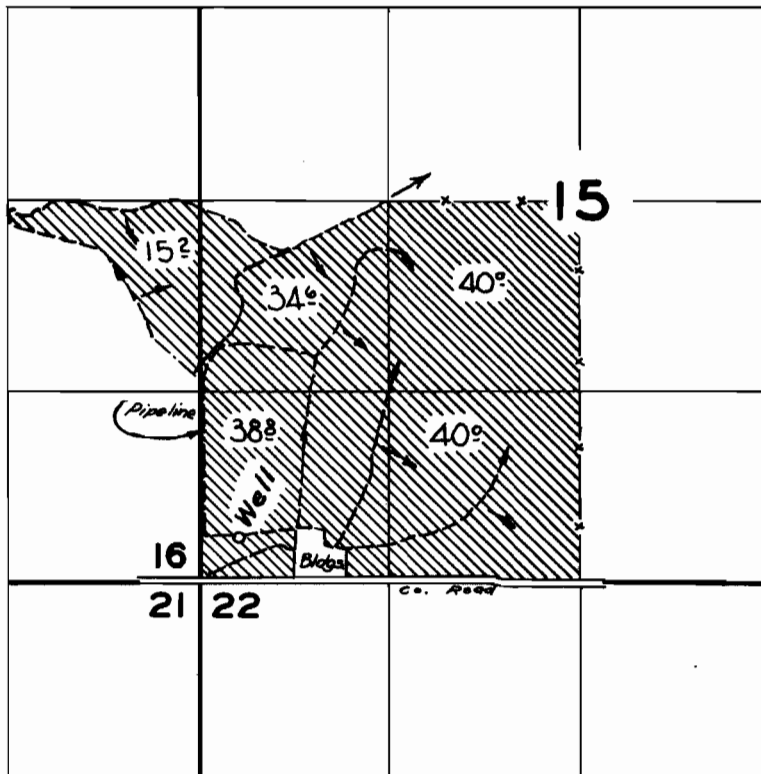

FINAL PROOF SURVEY
UNDER

Application No. U-410. Permit No. U-735
IN NAME OF

A. E. NICHOLS

Surveyed 15 Oct. 1958, by C. O. Bartels