


# T.26 S.R.33 E.W.M.

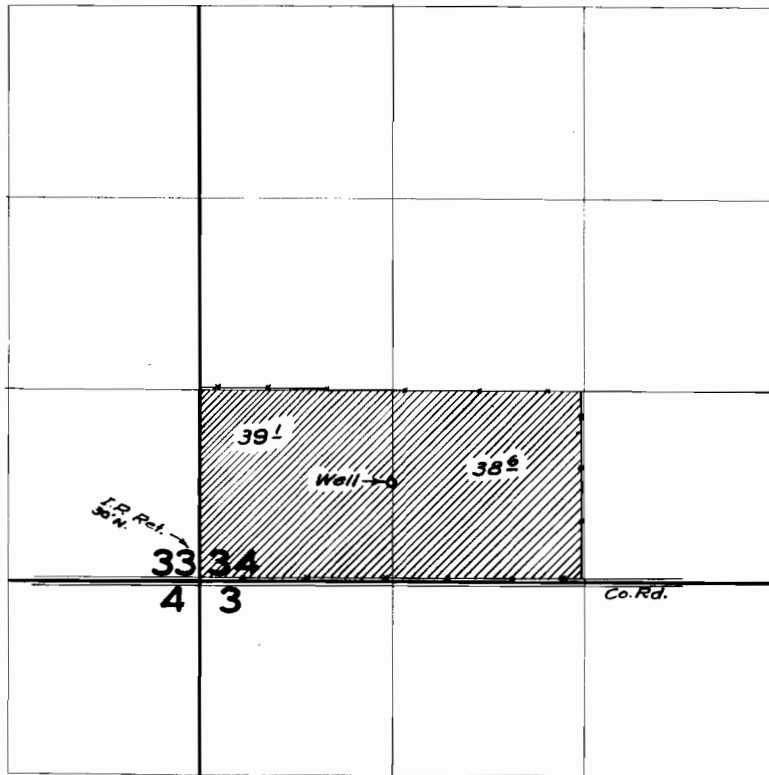

## FINAL PROOF SURVEY UNDER

Application No. G-332 Permit No. G-299  
IN NAME OF

GEORGE H. MERRICK

Surveyed 6 Aug. 1958, by M. Besh