


T. 19 S. R. 26 E. W.M.

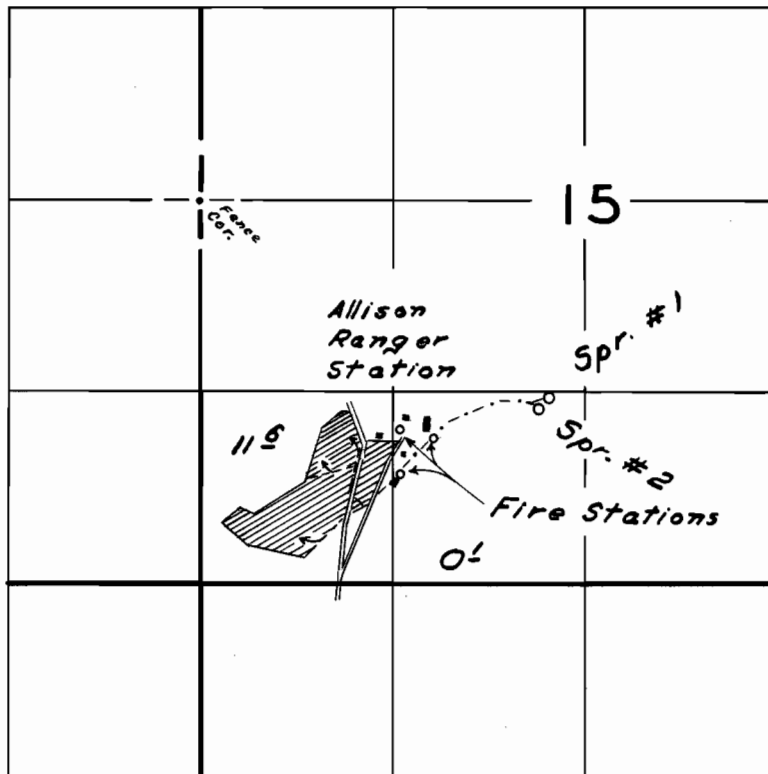

**FINAL PROOF SURVEY**  
UNDER

Application No. 17869 Permit No. 13563  
IN NAME OF

U.S. Forest Service - Ochoa Nat'l Forest

Surveyed Sept. 24 1958, by W.N. Perry