


T. 5&6S. R. 3W. W.M.

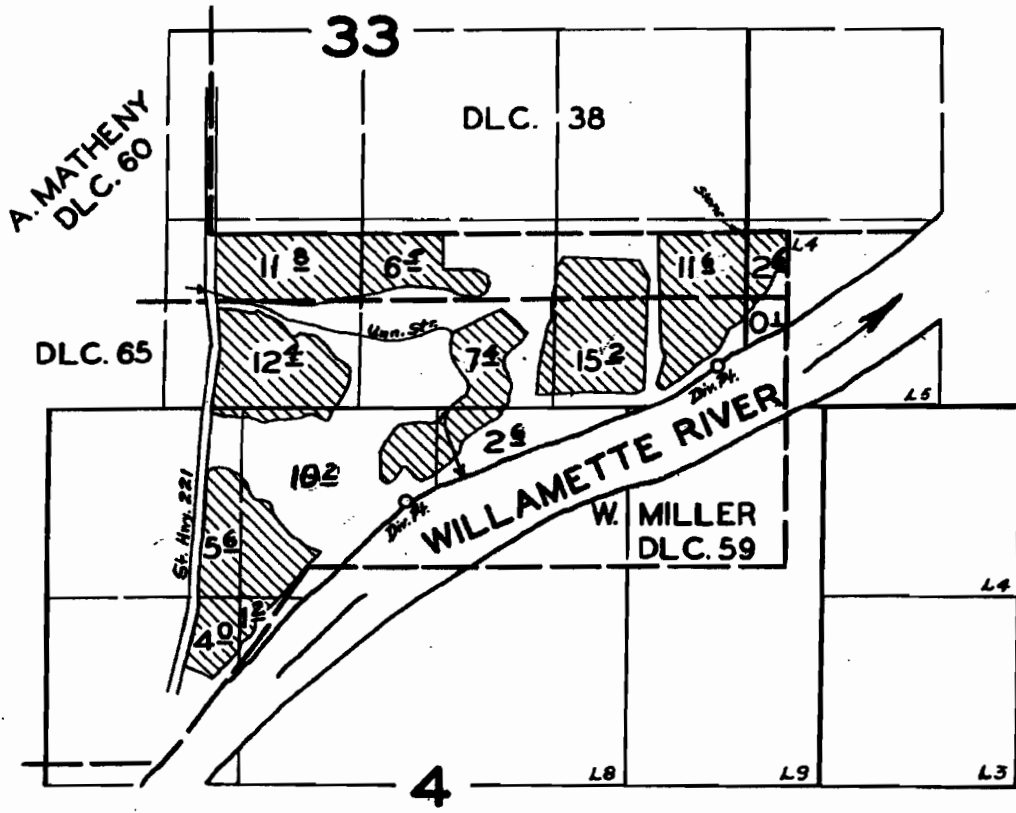

FINAL PROOF SURVEY UNDER

Application No. 17187 Permit No. 15567
IN NAME OF

FREDERICK H. ELEY

Surveyed APR. 3 1958, by m. Bish