


T. 23S. R. 6E. W.M.

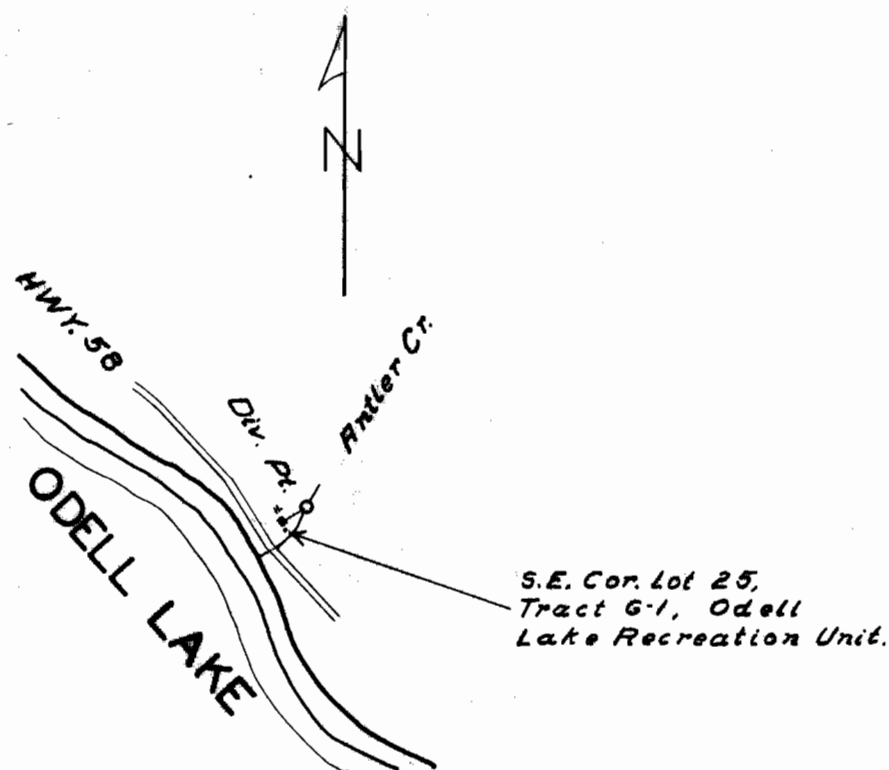

FINAL PROOF SURVEY
UNDER

Application No. 20928 Permit No. 16389
IN NAME OF

Floyd R. & Minor W. Billings

Surveyed Oct. 16 1958, by W. N. Perry