


T. 25S. R. 24E.W. M.

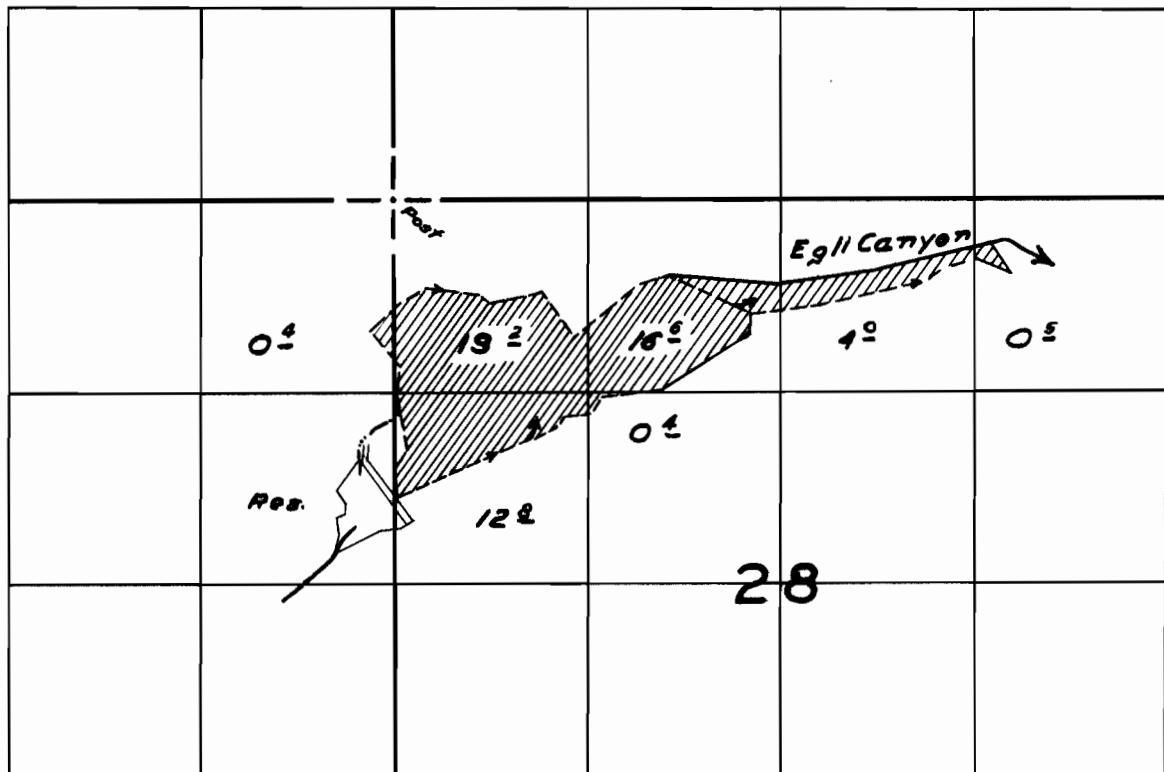

FINAL PROOF SURVEY
UNDER

R-22837 *R-903*
Application No. *22838* Permit No. *18006*
IN NAME OF

George C. West

Surveyed *Sept. 25 1958*, by *W. N. Perry*