


18006
c#26201

T. 25S. R. 24E. W. M.

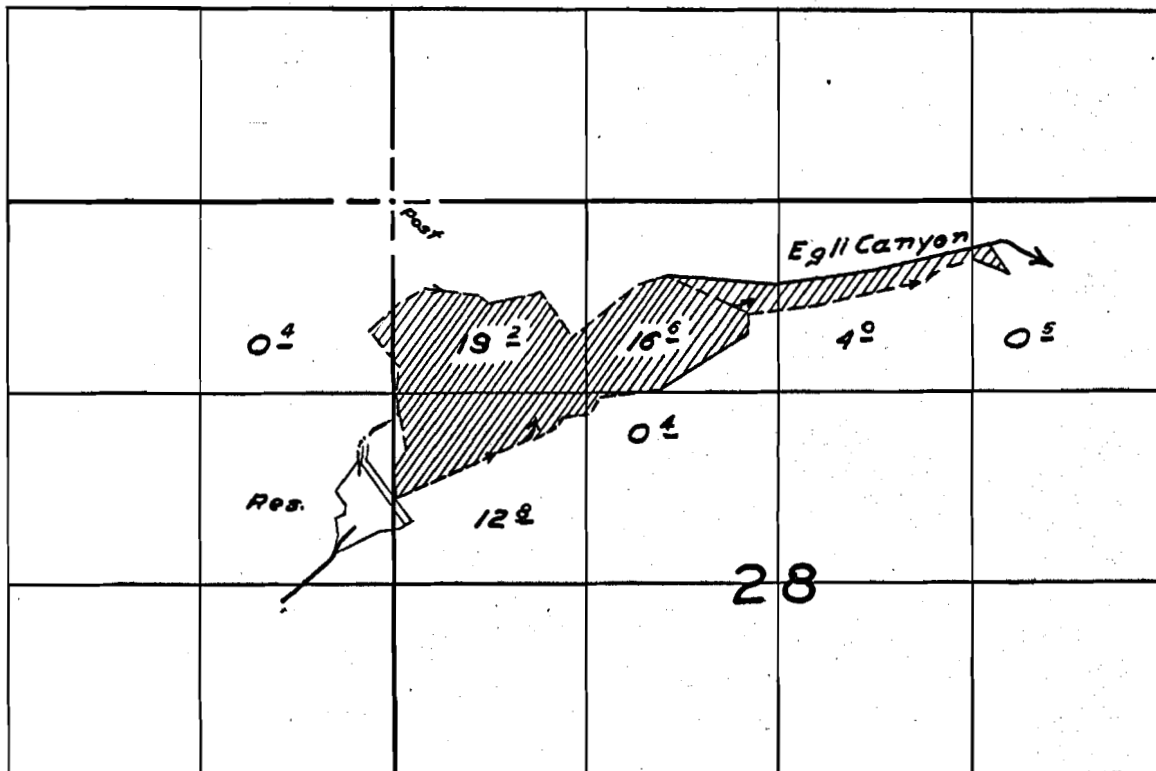

FINAL PROOF SURVEY
UNDER

R-22837 R-903
Application No. 22838 Permit No. 18006
IN NAME OF

George C. West

Surveyed Sept. 25 1958, by W.N. Perry

25-24V

1958-47