


T. 26S. R. 24E. W.M.

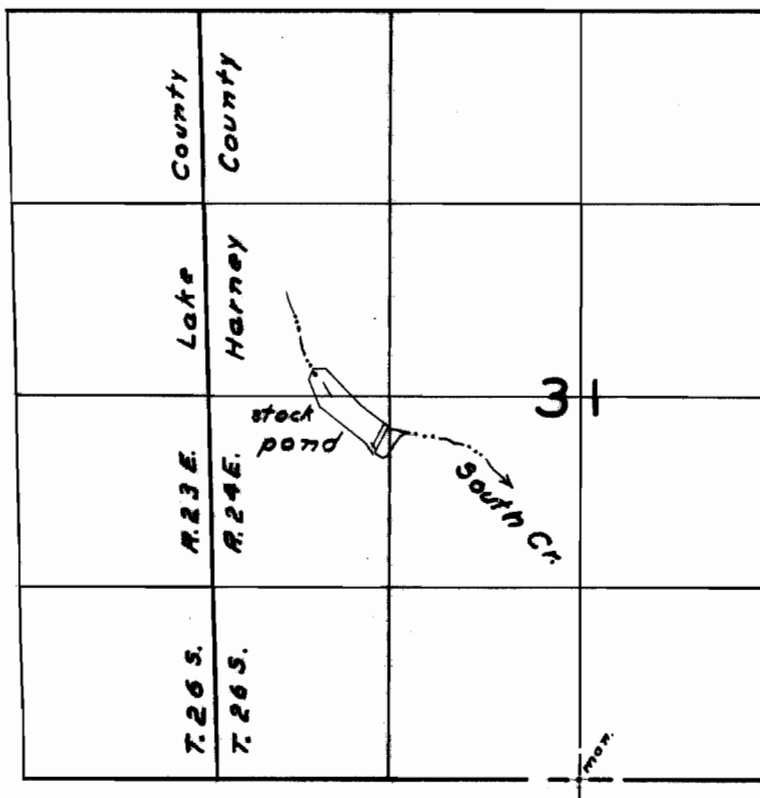

FINAL PROOF SURVEY
UNDER

Application No. R-23041 29569 Permit No. R-949 23291
IN NAME OF

George C. West

Surveyed Sept. 25 1952, by W. N. Perry