


T. 26S. R. 24E. W.M.

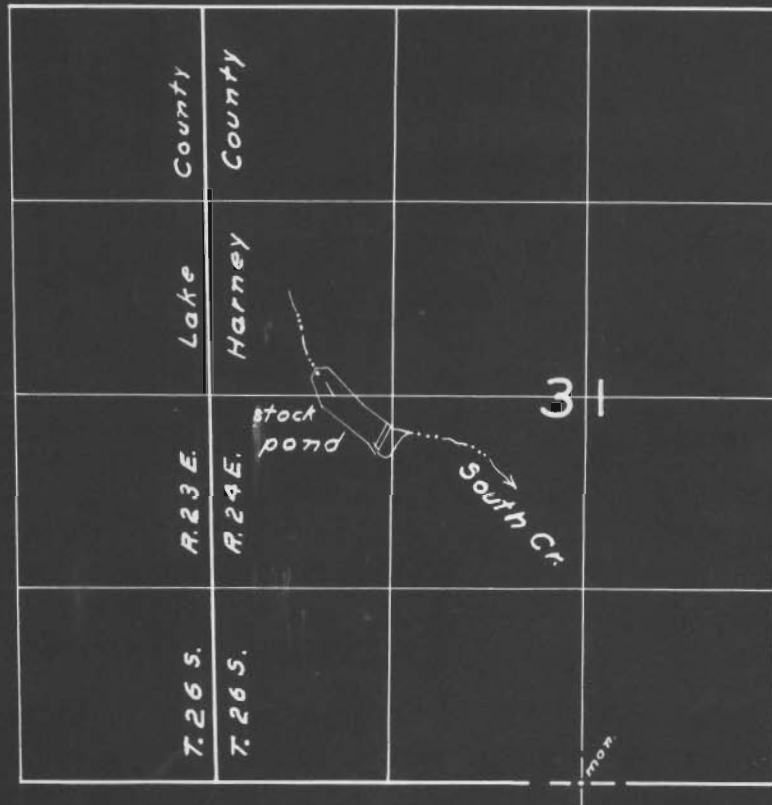

FINAL PROOF SURVEY
UNDER

Application No. *R-23041* Permit No. *R-949*
23569 IN NAME OF *23291*


George C. West

Surveyed *Sept. 25 1958*, by *W. N. Perry*

MAP
TO ACCOMPANY APPLICATION FOR PERMIT
TO APPROPRIATE THE PUBLIC WATERS
OF THE STATE OF OREGON

GEORGE C WEST

APPLICANT

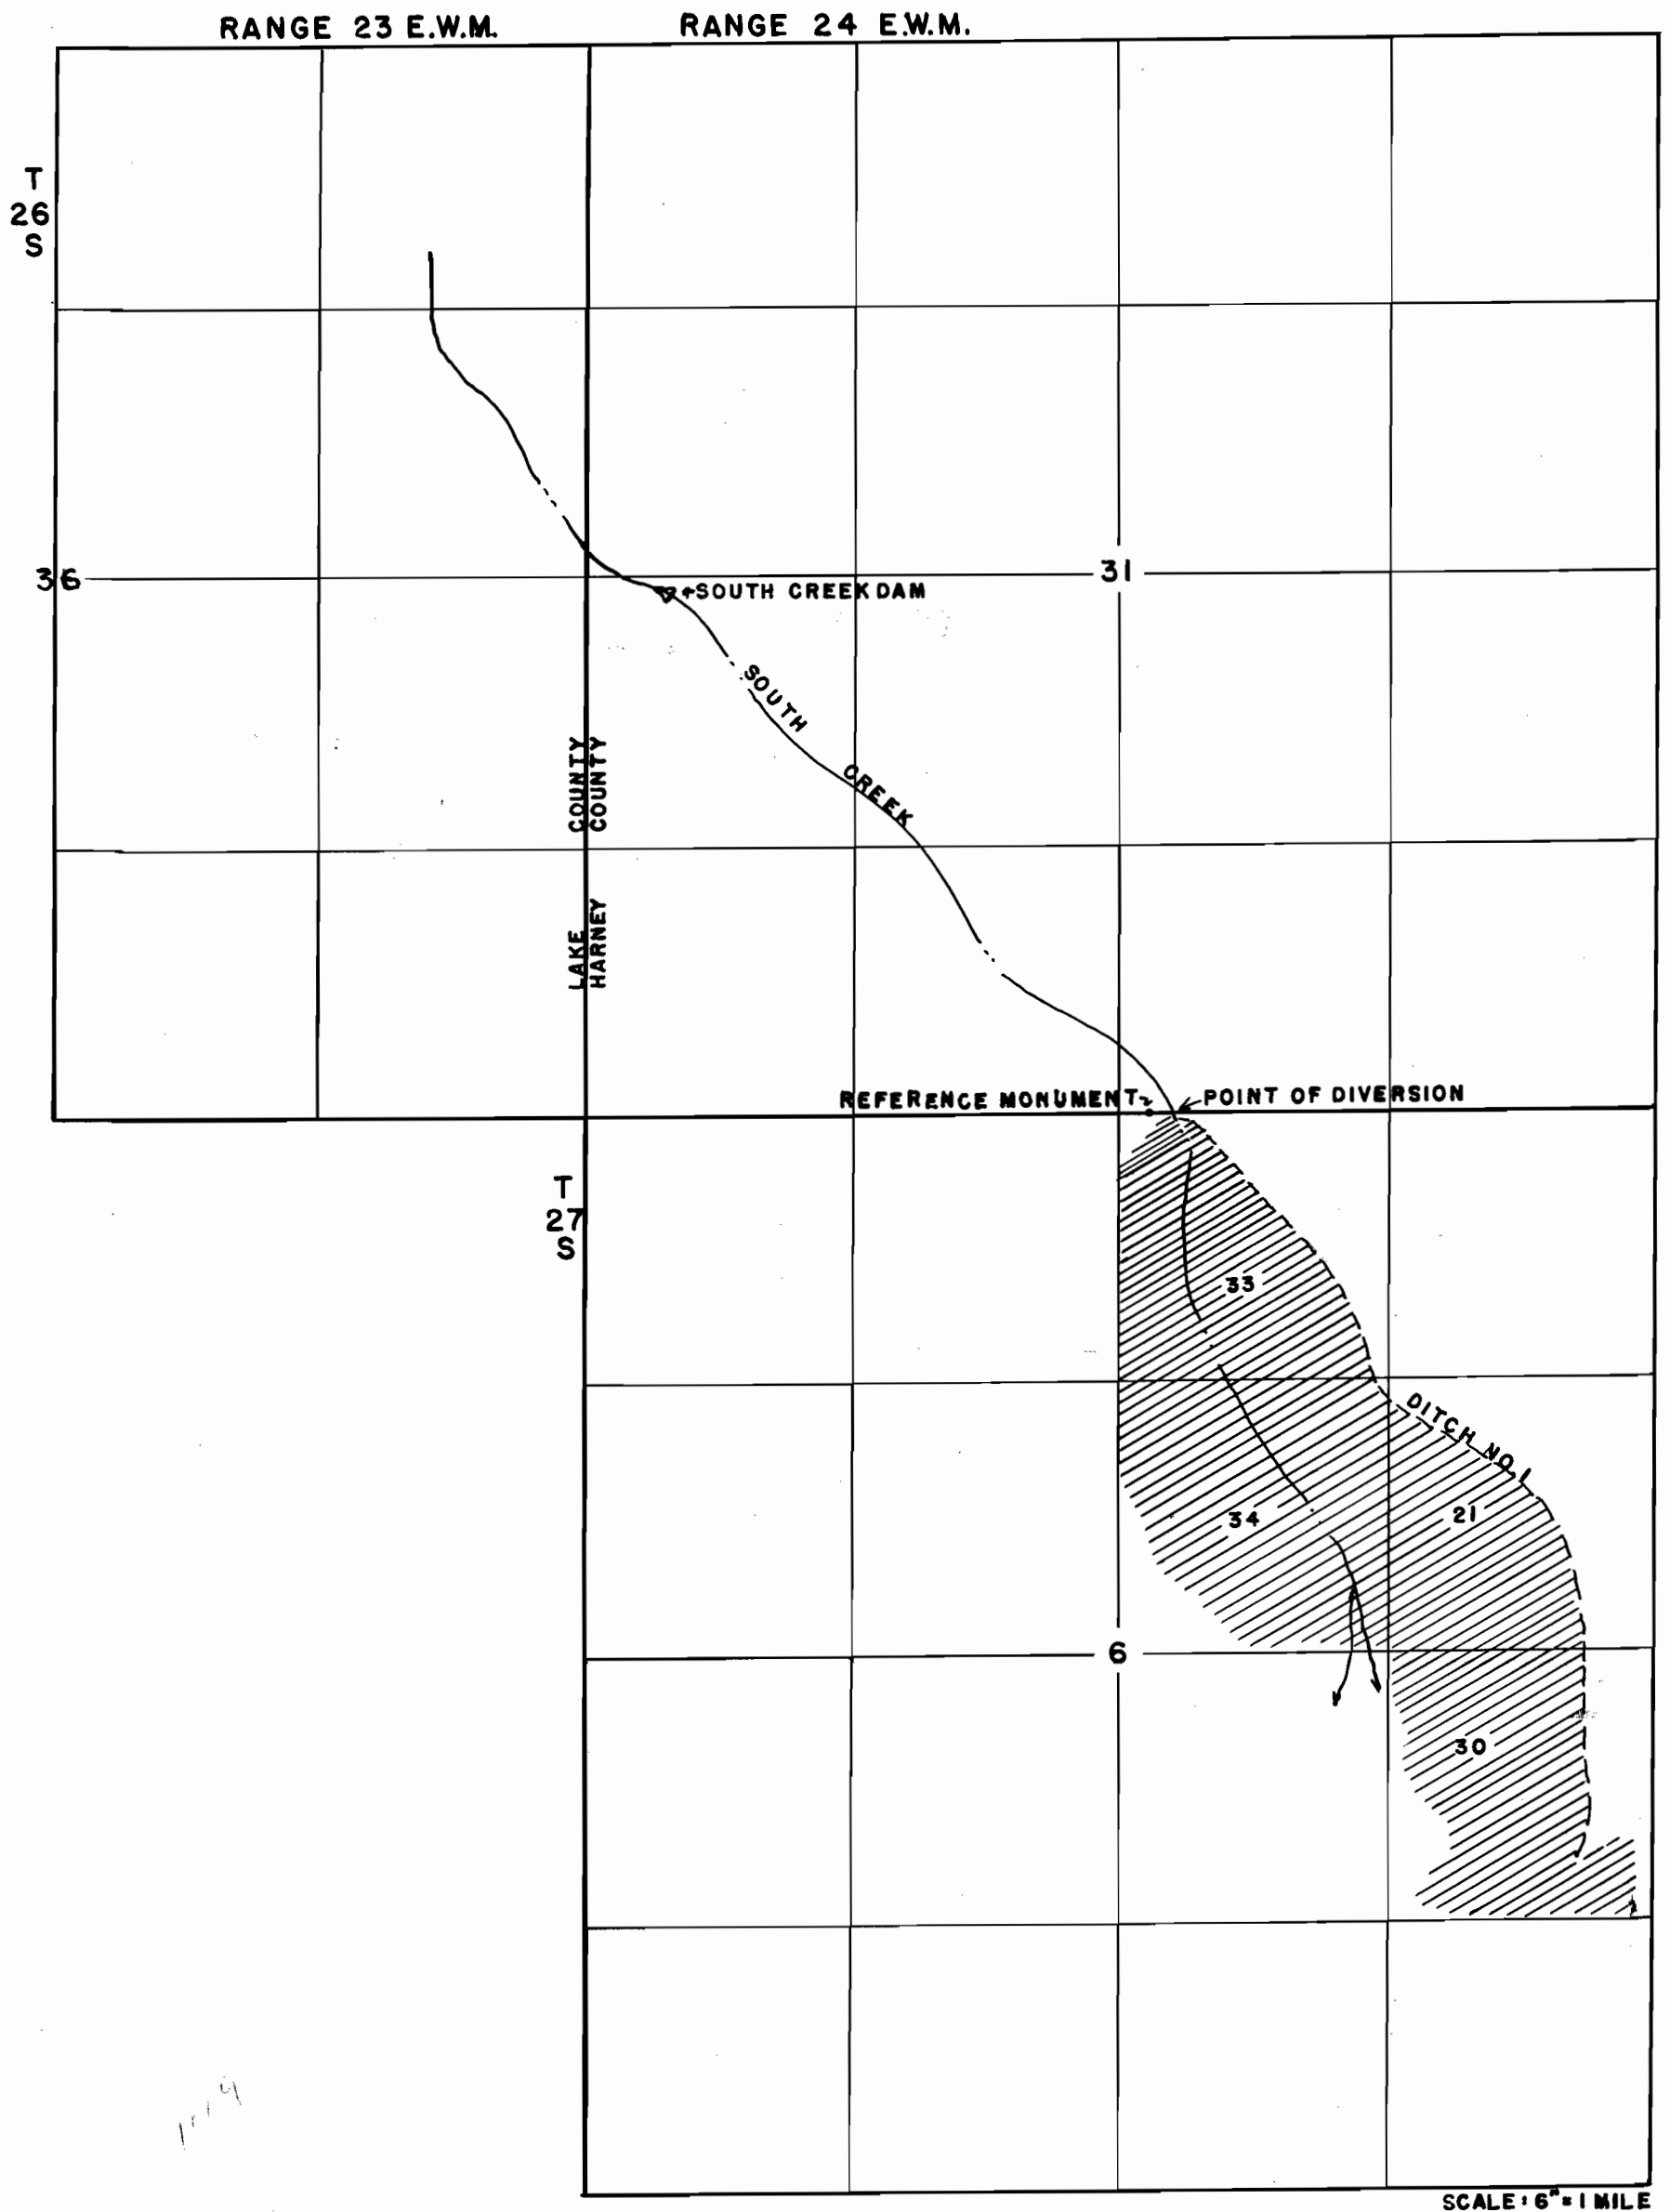

I, PAUL R. REVIS OF BURNS, OREGON, DO HEREBY CERTIFY THAT THIS MAP WAS
MADE FROM NOTES TAKEN DURING AN ACTUAL SURVEY MADE BY ME ON DECEMBER
10, 1947; THAT THE MONUMENT SHOWN ON THIS CONSISTING OF AN IRON PIPE
IS 307.0 FEET EAST OF THE N 1/4 CORNER OF SECTION 6, TWP. 27 SOUTH.
RANGE 24 E.W.M. TO WHICH TIE IS MADE.

OREGON LICENSE NO. 2511

Paul R. Revis
REGISTERED PROFESSIONAL ENGINEER.

Application No. R-23041
22960

Permit No. R-949
1-3

Application No. 29569
Permit No. 23291