


T.18S. R.37E.W.M.

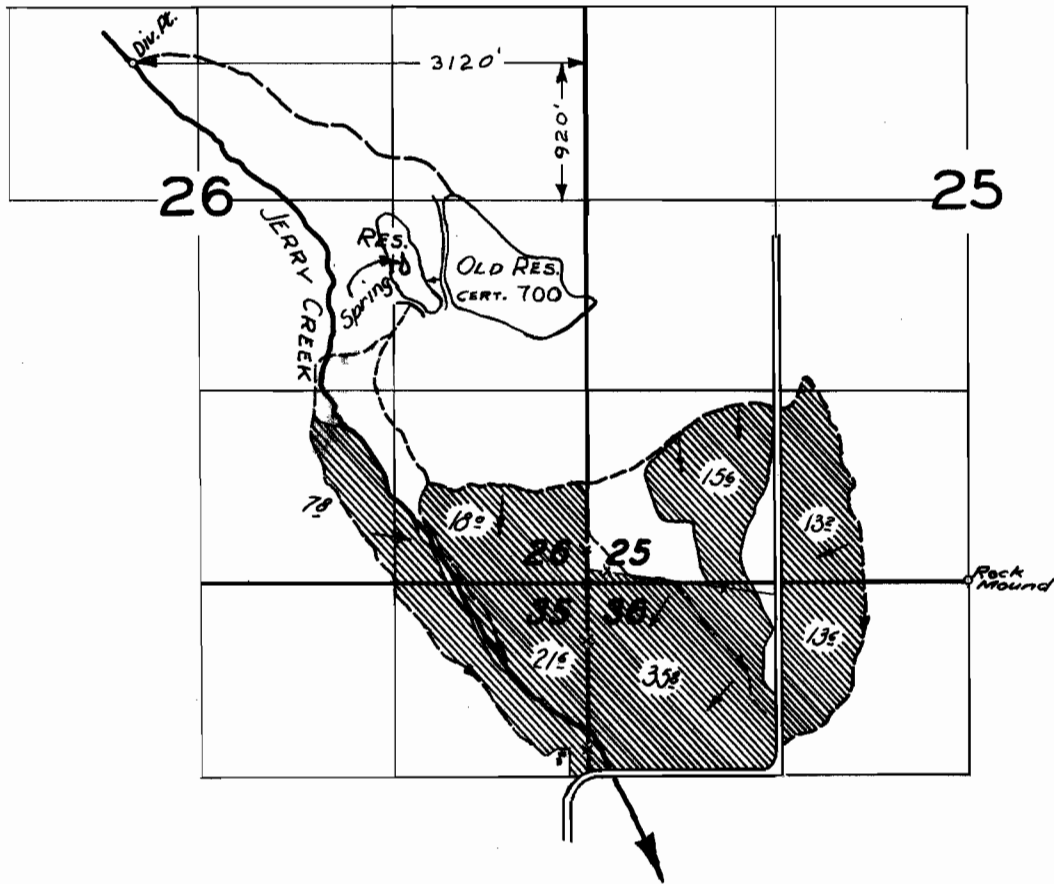

**FINAL PROOF SURVEY**  
UNDER

45693                      34116  
R-23451                    R-955  
Application No. 23466... Permit No. 18513...  
IN NAME OF

**WM. BUTLER**

Surveyed 23 Oct. 1958, by C. O. Bartels.  
MAY 12, 1975            L. H. NUNN