


T.18S. R.37E. W.M.

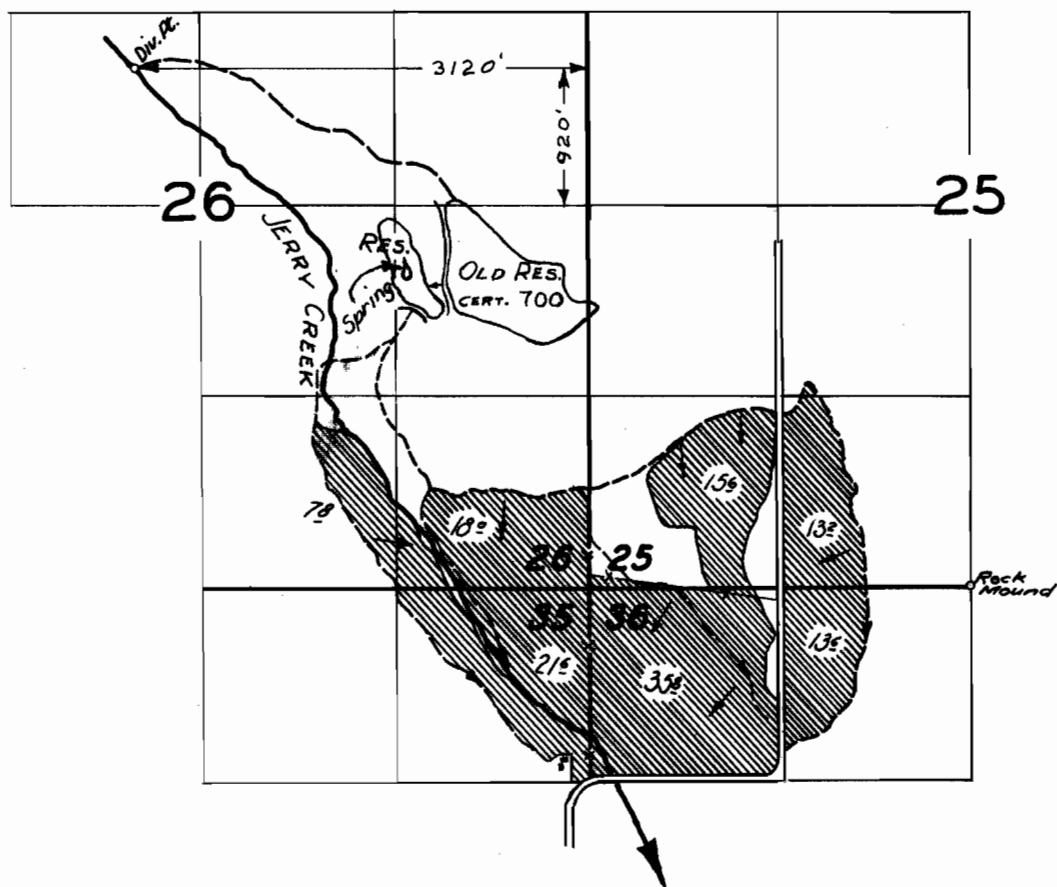

FINAL PROOF SURVEY
UNDER

45693 34116
R-23451 R-955
Application No. 23466... Permit No. 18513...
IN NAME OF

WM. BUTLER

Surveyed 23 Oct. 1958, by C. O. Bartels.
MAY 12, 1975 L. H. NUNN