


T. 3 S. R. 2 W. W. M.

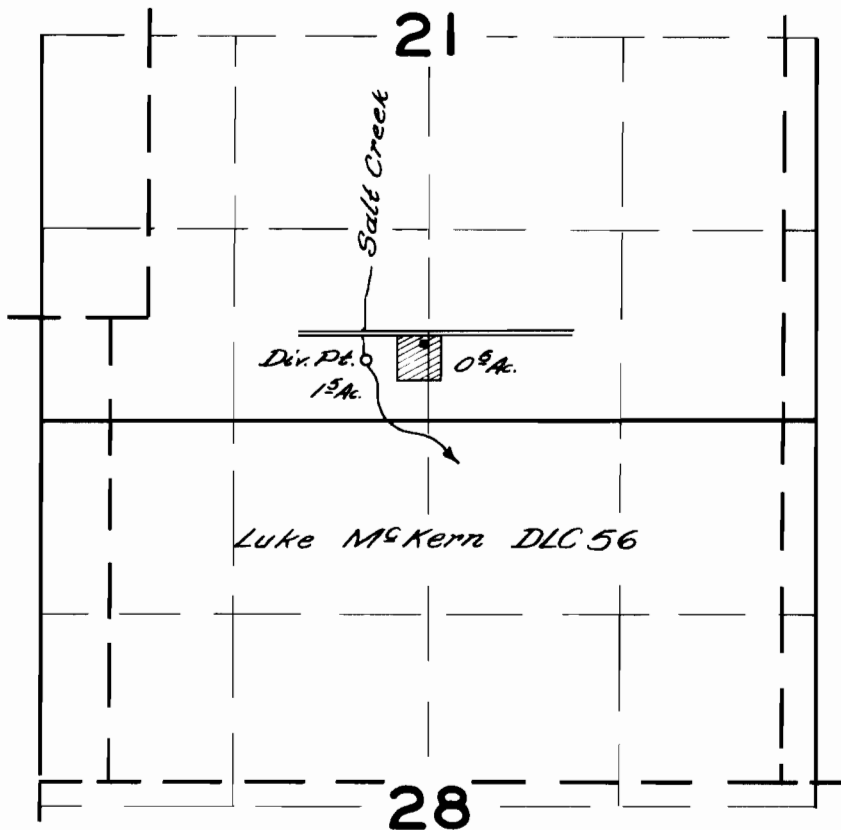

**FINAL PROOF SURVEY**  
UNDER

Application No. 23939. Permit No. 18852.  
IN NAME OF

..... *Dessie L. Kiser* .....

Surveyed *May 14* 1958, by *M. Bisk* .....