


T.29 S.R.12 W.W.M.

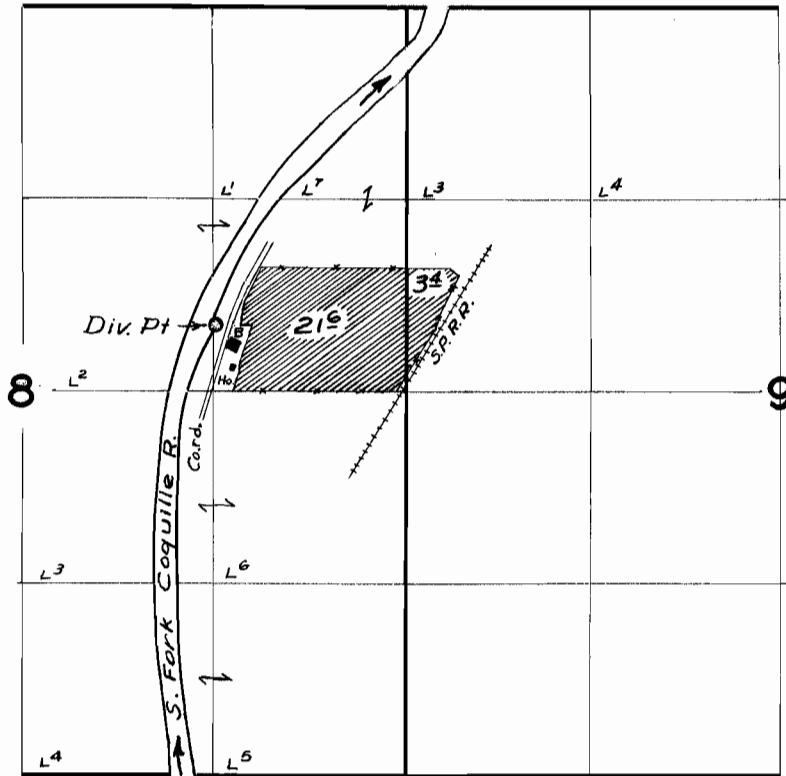

FINAL PROOF SURVEY UNDER

Application No. 25138 Permit No. 19778
IN NAME OF

Russell P. Evans

Surveyed 20 June 1958, by Tom Bish