


T.30S.R6.W.W.M.

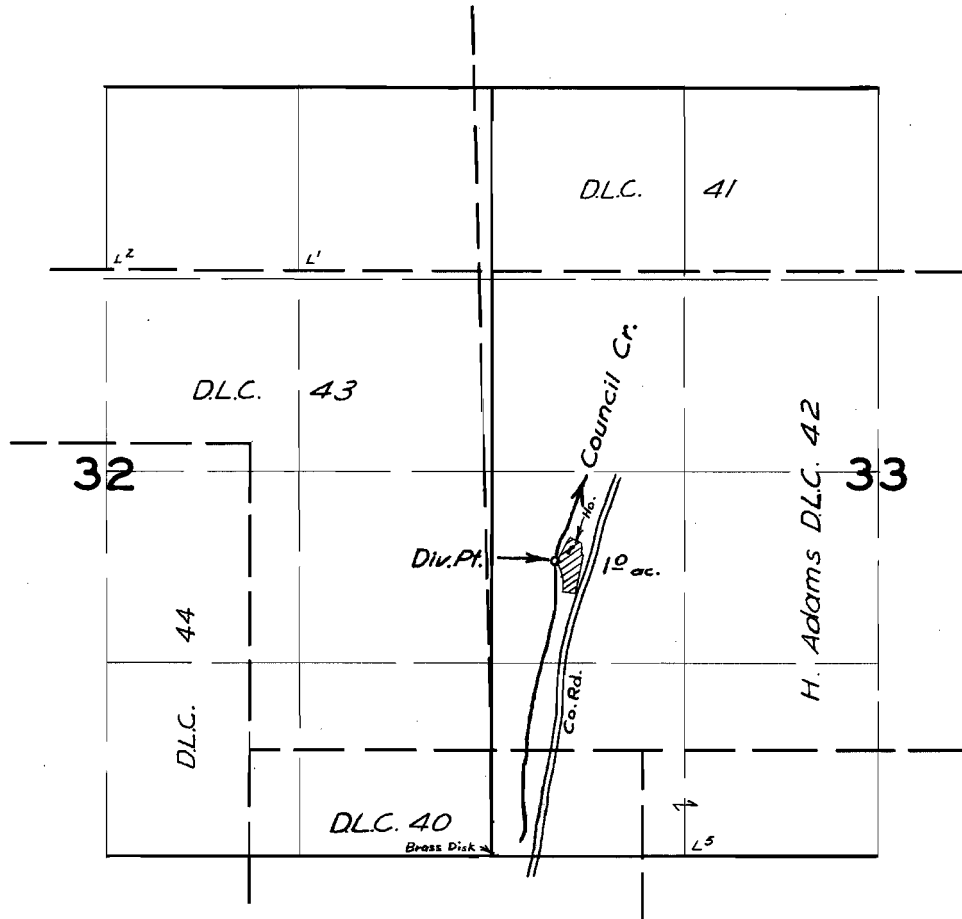

**FINAL PROOF SURVEY**  
UNDER

Application No. 26623 Permit No. 20847  
IN NAME OF

Floyd Smith

Surveyed July 25, 1957, by M. B. Bish