


# T.25 S.R.12 W.W.M.

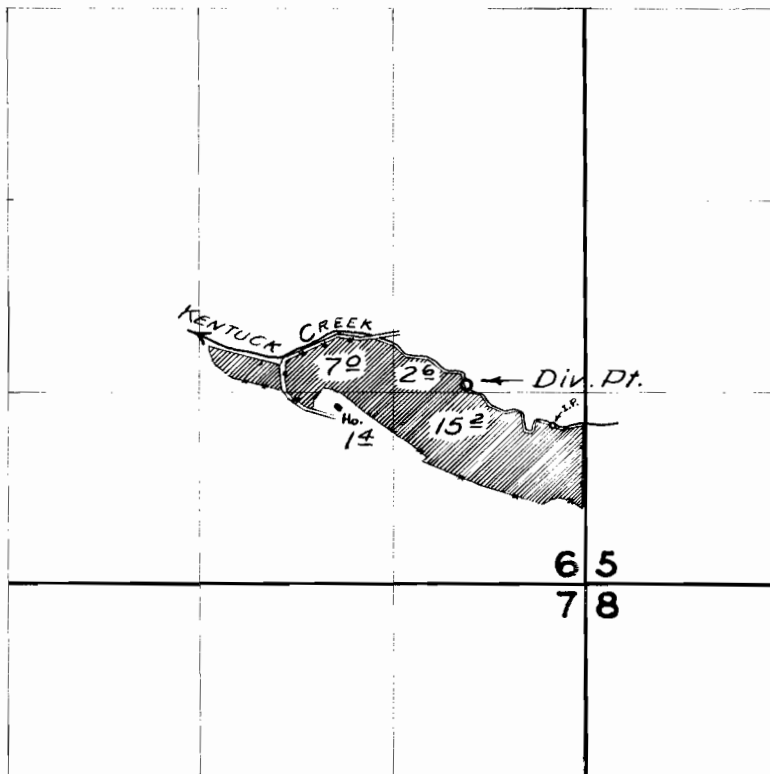

## FINAL PROOF SURVEY UNDER

Application No. 26649 Permit No. 20874  
IN NAME OF

*C. V. &/OR. P. A. FREUDE*

Surveyed 12 July 1958, by *M. Bish*