


T. 5S. R. 5W. W.M.

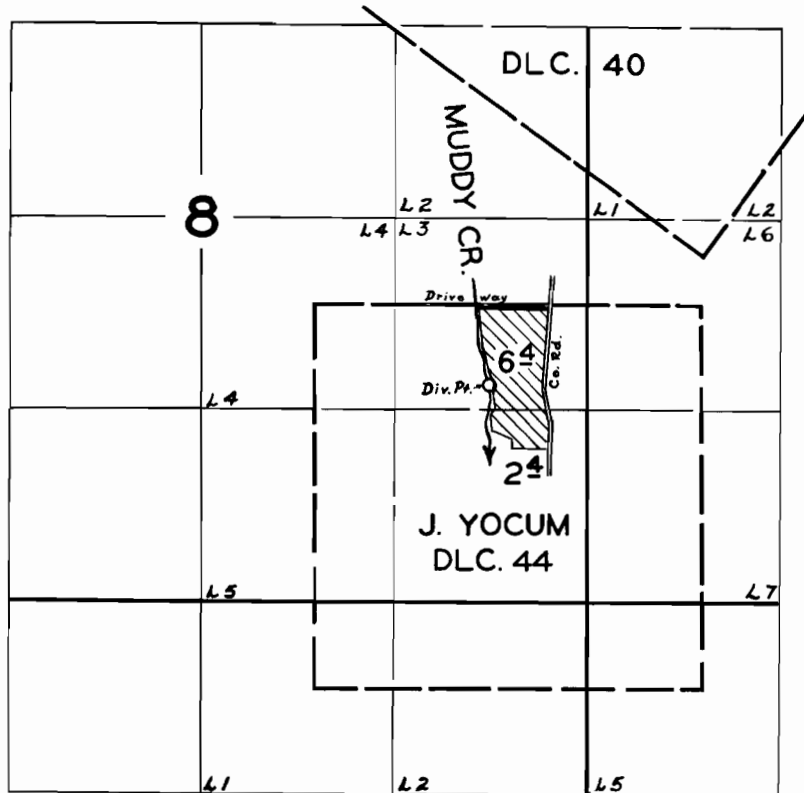

FINAL PROOF SURVEY
UNDER

Application No. 26937 Permit No. 21164
IN NAME OF

MILTON D. HAMILTON

Surveyed APR. 8 1958, by M. BISH