


T. 2N. R. 4W. W.M.

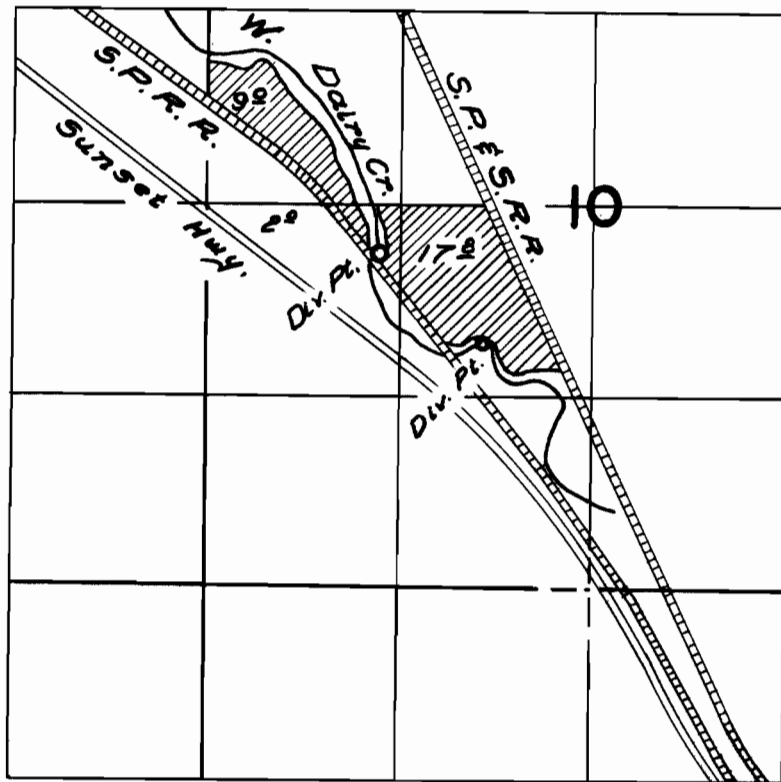

FINAL PROOF SURVEY
UNDER

Application No. 25915 Permit No. 21241
IN NAME OF

Robert E. Day

Surveyed July 2 1958, by M. B. Ash