


T. 4S. R. 3E. W.M.

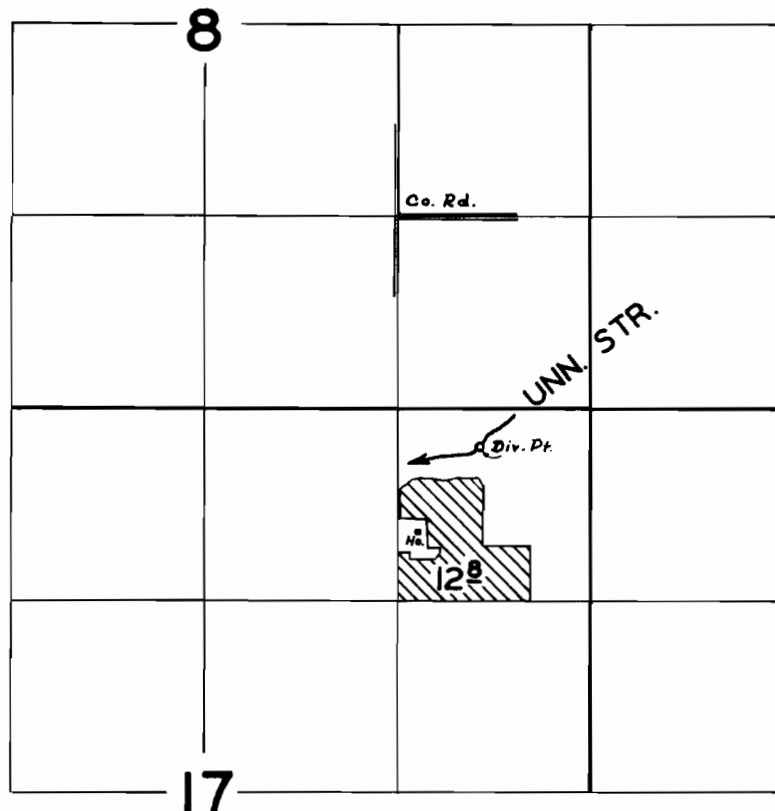

FINAL PROOF SURVEY
UNDER

Application No. 27167 Permit No. 21365
IN NAME OF

JOHN WIEGELE

Surveyed 25 AUG. 1958, by M. BISH