


T. 2N. R. 4W. W.M.

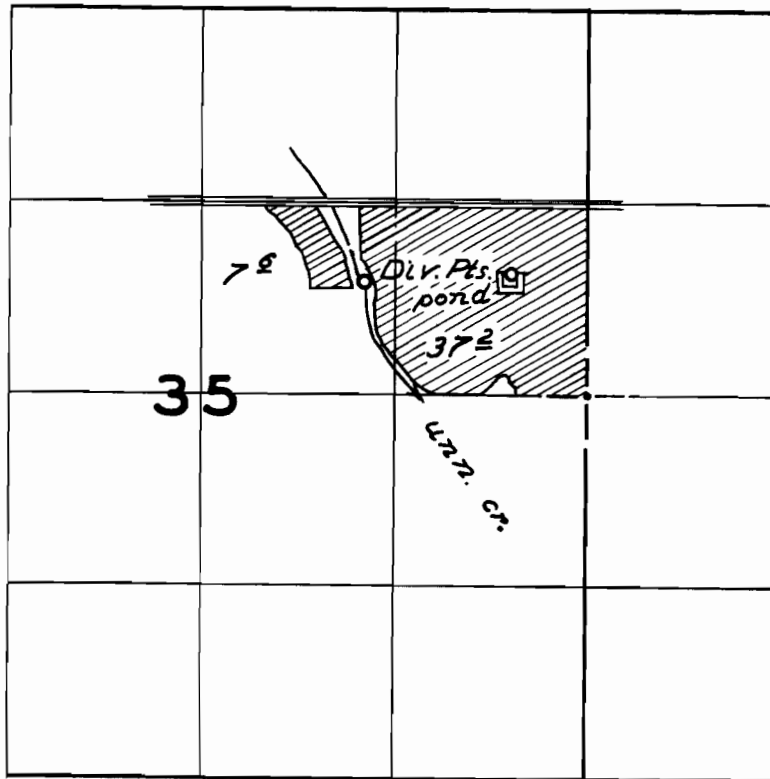

**FINAL PROOF SURVEY**  
UNDER

Application No. 27133 Permit No. 21412  
IN NAME OF

*Henry J. Sandberg*

Surveyed July 1, 1958, by *M. Bish*