


T.3 S.R.24 E.W.M.

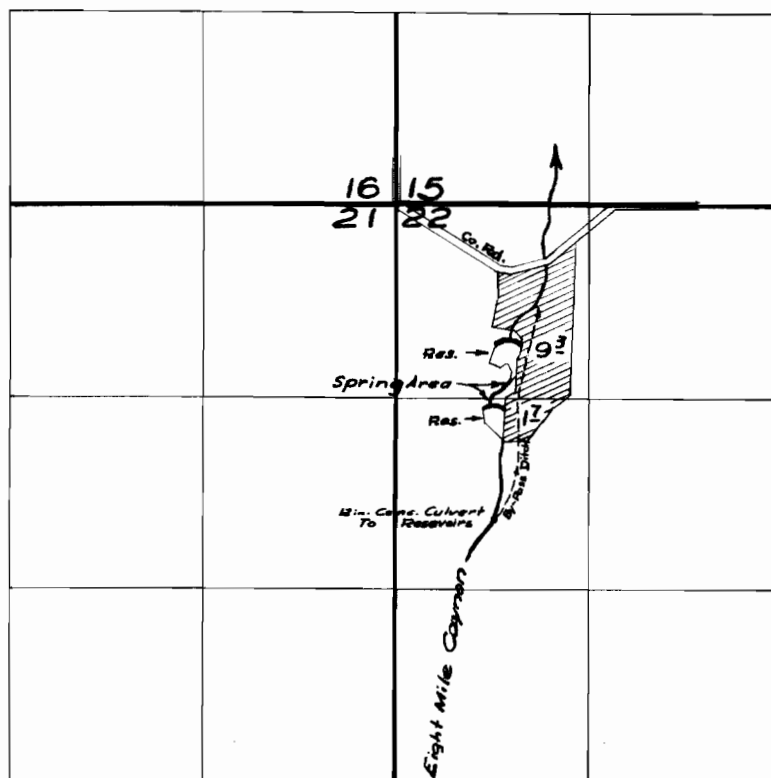

FINAL PROOF SURVEY UNDER

R30801 R-1888
 30802 24314
 Application No. 27818 Permit No. 21823
 IN NAME OF

Surveyed 17 Oct. 1958, by M. B. Bish