


T. 5S. R. 3W. W.M.

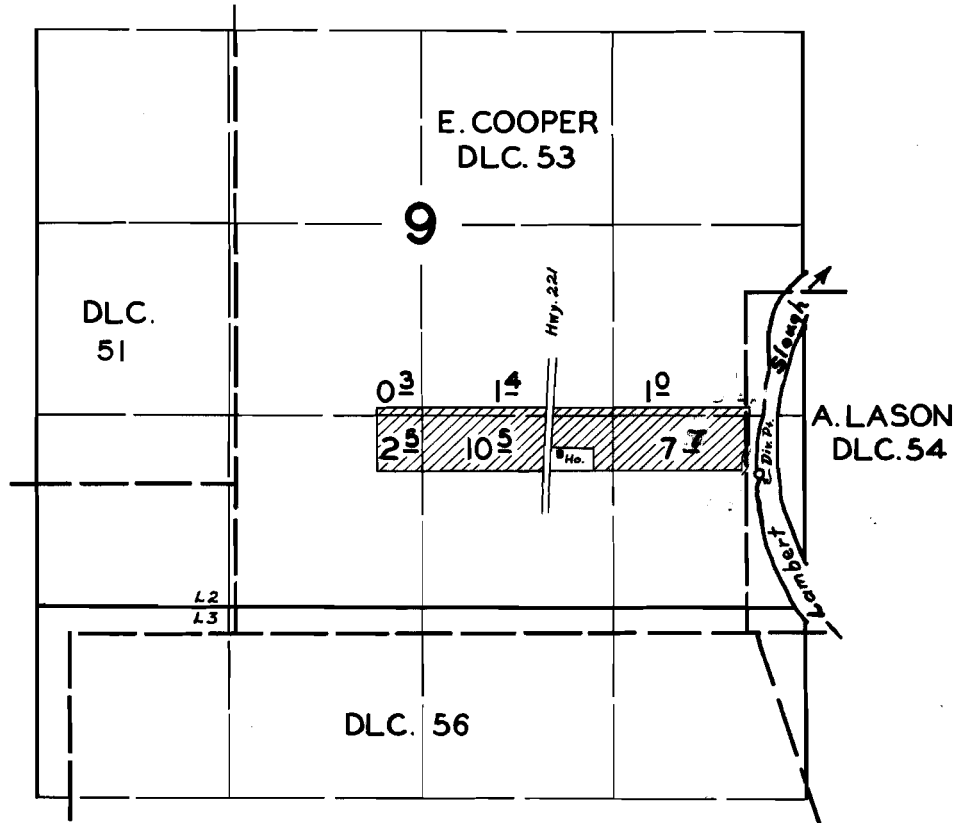

FINAL PROOF SURVEY
UNDER

Application No. 27735. Permit No. 21845.
IN NAME OF

MRS. CORA S. BROWN

Surveyed APR. 1. 1958, by M. BISH