


T. 5S. R. 8W. W. M.

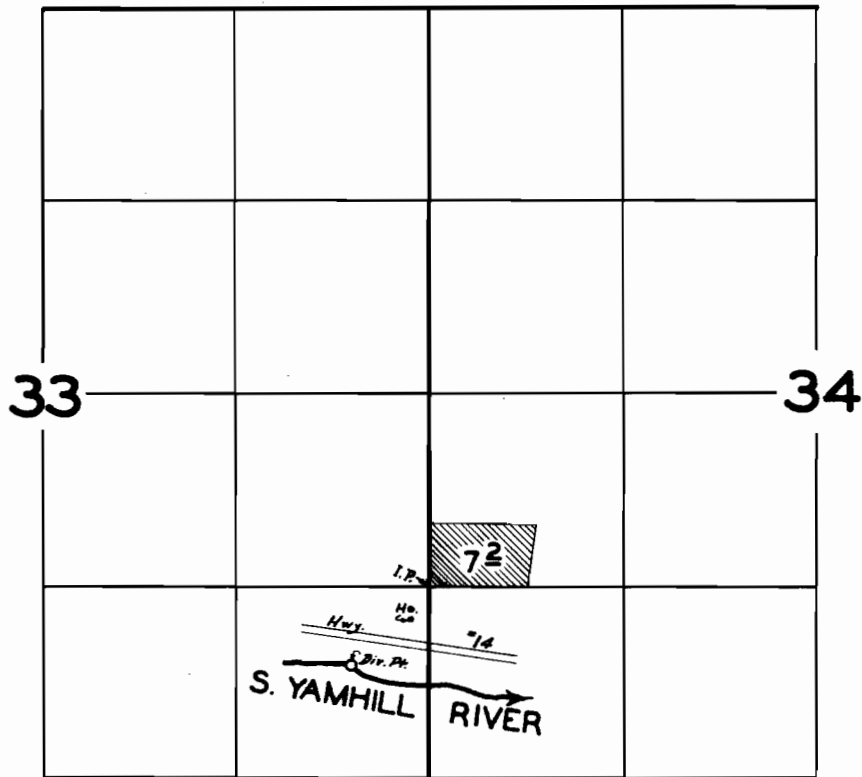

FINAL PROOF SURVEY
UNDER

Application No. 27871... Permit No. 21958
IN NAME OF

..... ROY AND MARY HOLSCLAW

Surveyed JUNE 2, 1958, by M. BISH