


T. 5S. R. 8W. W.M.

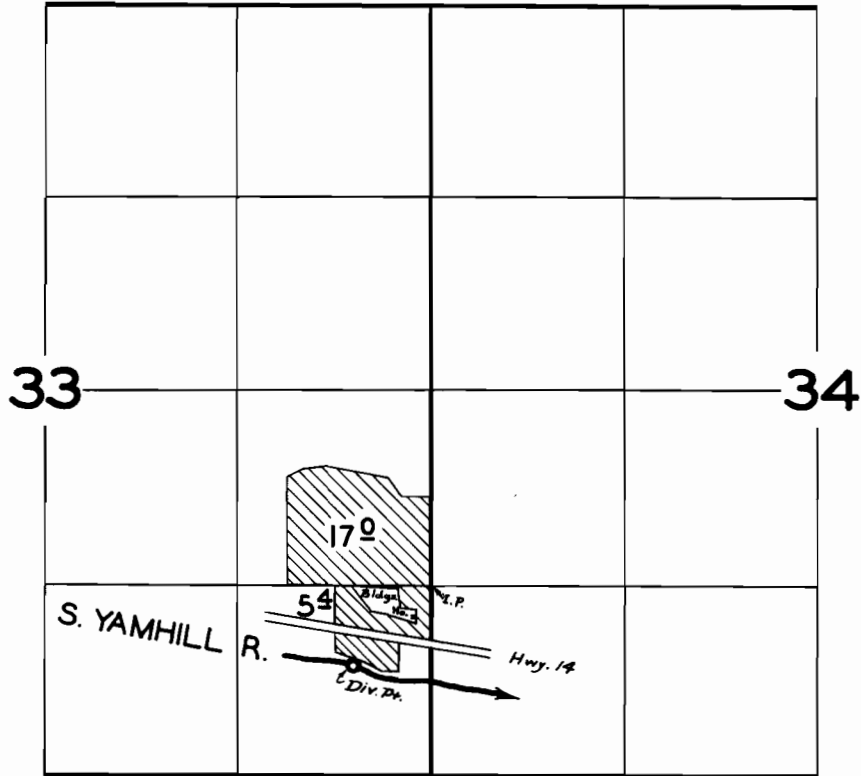

**FINAL PROOF SURVEY**  
UNDER

Application No. 30037 Permit No. 23646  
IN NAME OF

**ROY AND MARY HOL SCLAW**

Surveyed JUNE 2, 1958, by M. BISH