


T.12S. R.5 W.W.M.

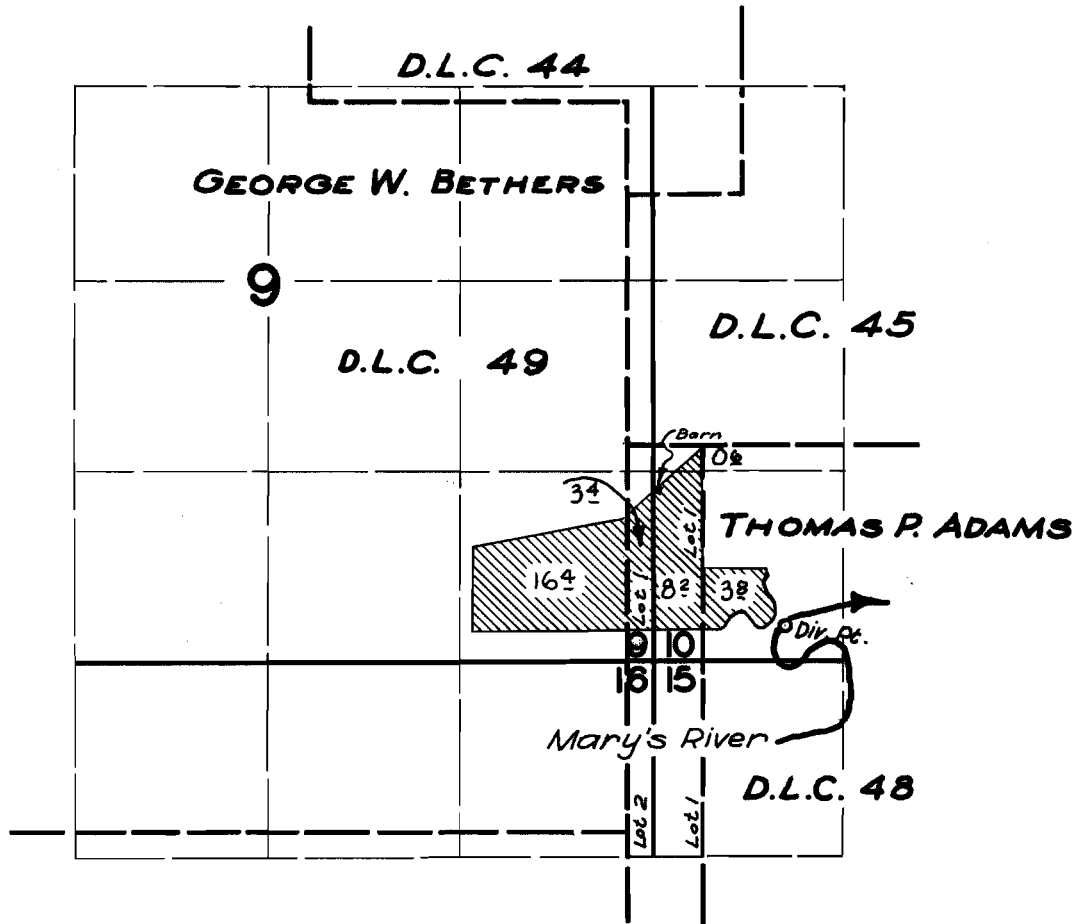

FINAL PROOF SURVEY
UNDER

Application No. 27,844 Permit No. 22104.
IN NAME OF

ROBERT L. SKELTON

Surveyed 22 Sept. 1958, by M. Bish.....

Rj