


T.27 S.R.13 W.W.M.

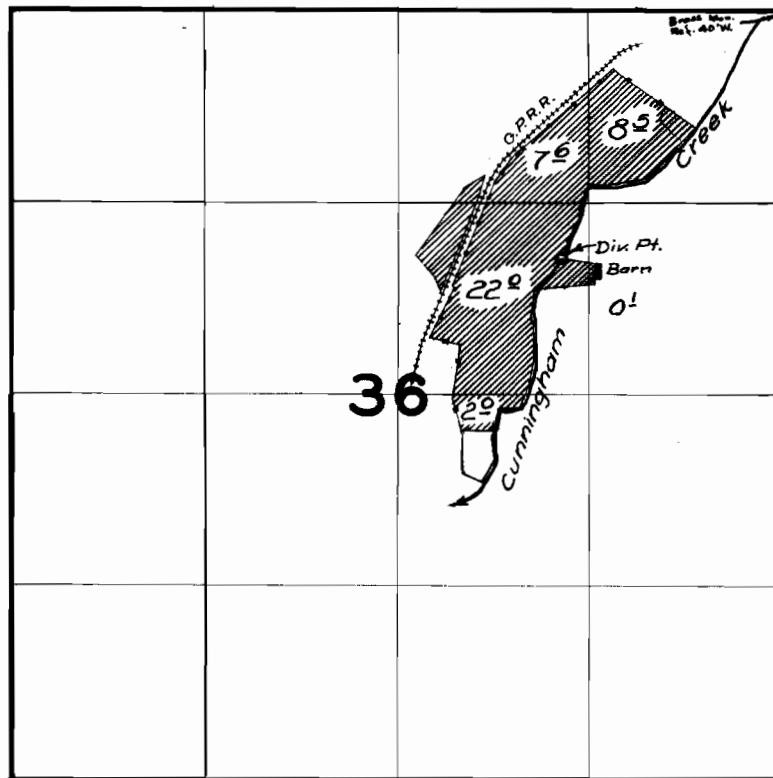

**FINAL PROOF SURVEY**  
UNDER

Application No. 28123 Permit No. 22136  
IN NAME OF

Joe A. Scolari

Surveyed 11 June 1958, by M. Bish

APPEARS THERE IS  
A 100' BULL IN THE  
NE'ly direction  
based upon photo

41011-180-196B

12-14-88

  
Jeff Larson