


# T.32 S.R.5 W.W.M.

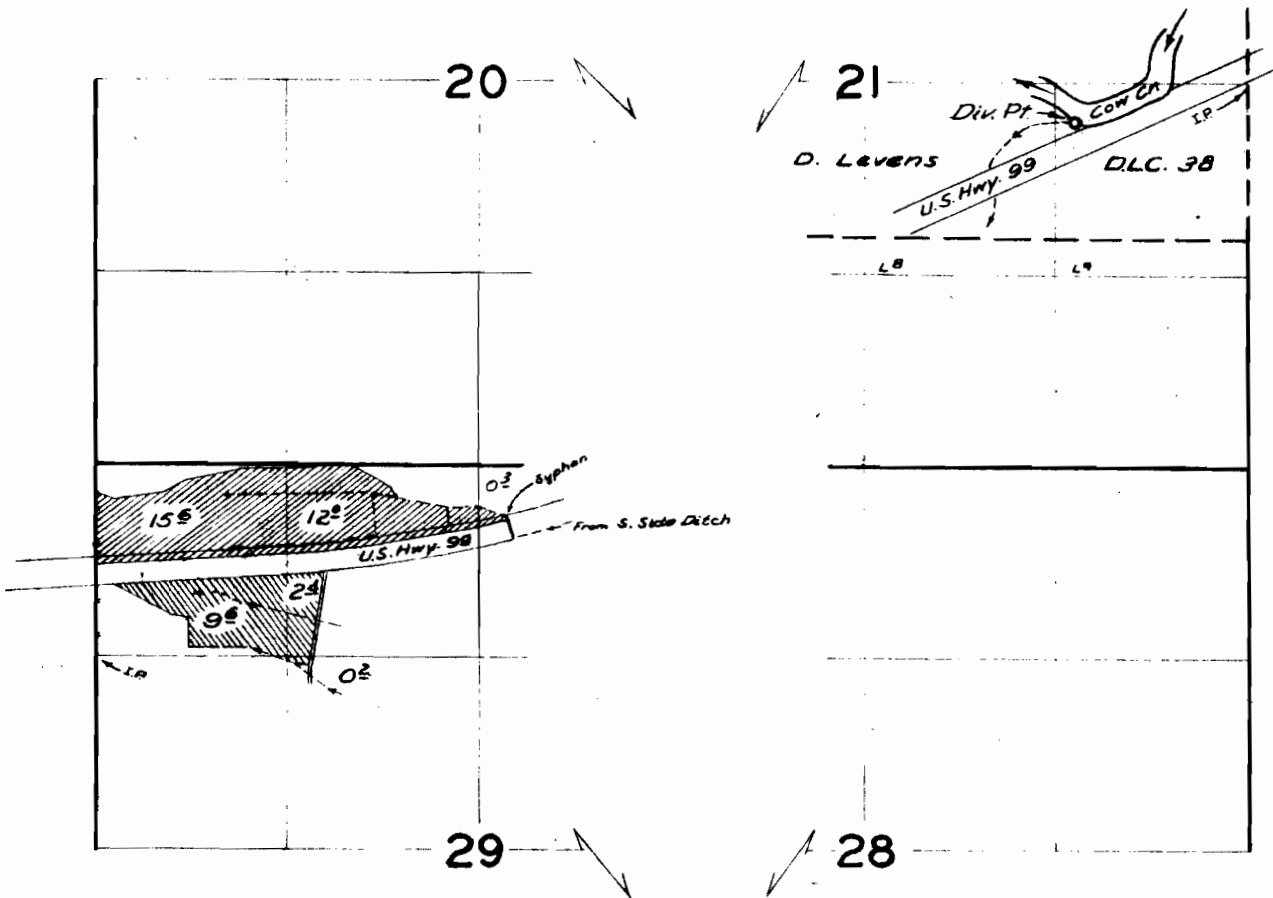

## FINAL PROOF SURVEY UNDER

Application No. 28771 Permit No. 22624 IN NAME OF

DAN F. CLARE

Surveyed 4 Sept. 1958, by M. Bish