


T.32 R.5 W.W.M.

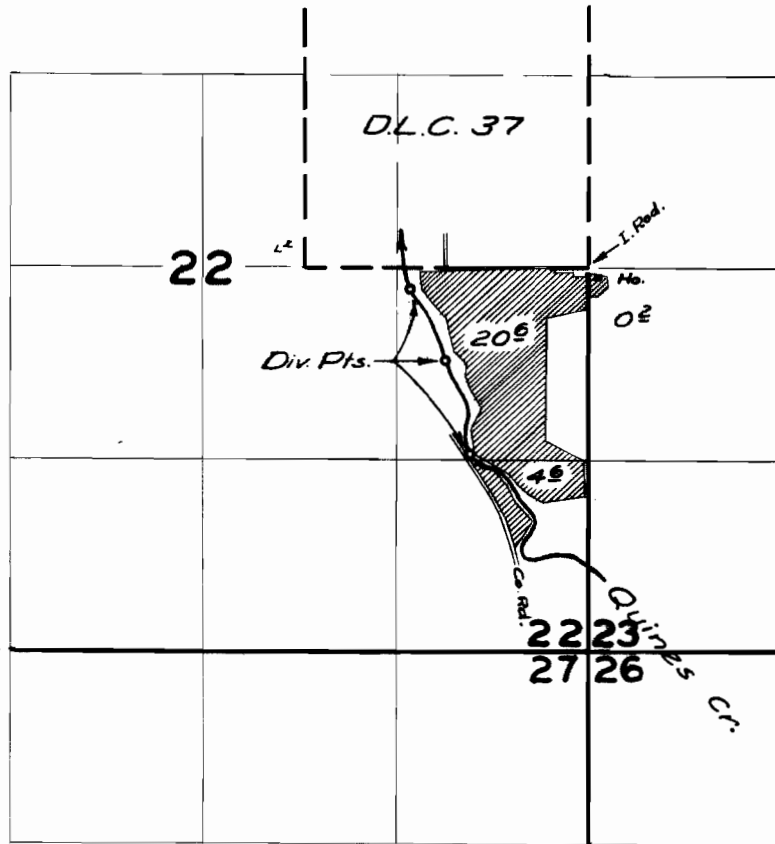

FINAL PROOF SURVEY
UNDER

Application No. ~~28849~~ Permit No. 22695
IN NAME OF

HENRY C. TANNER

Surveyed *5 Sept.* 1958, by *M. Beh*