


T.6S. R. 1E.W.M.

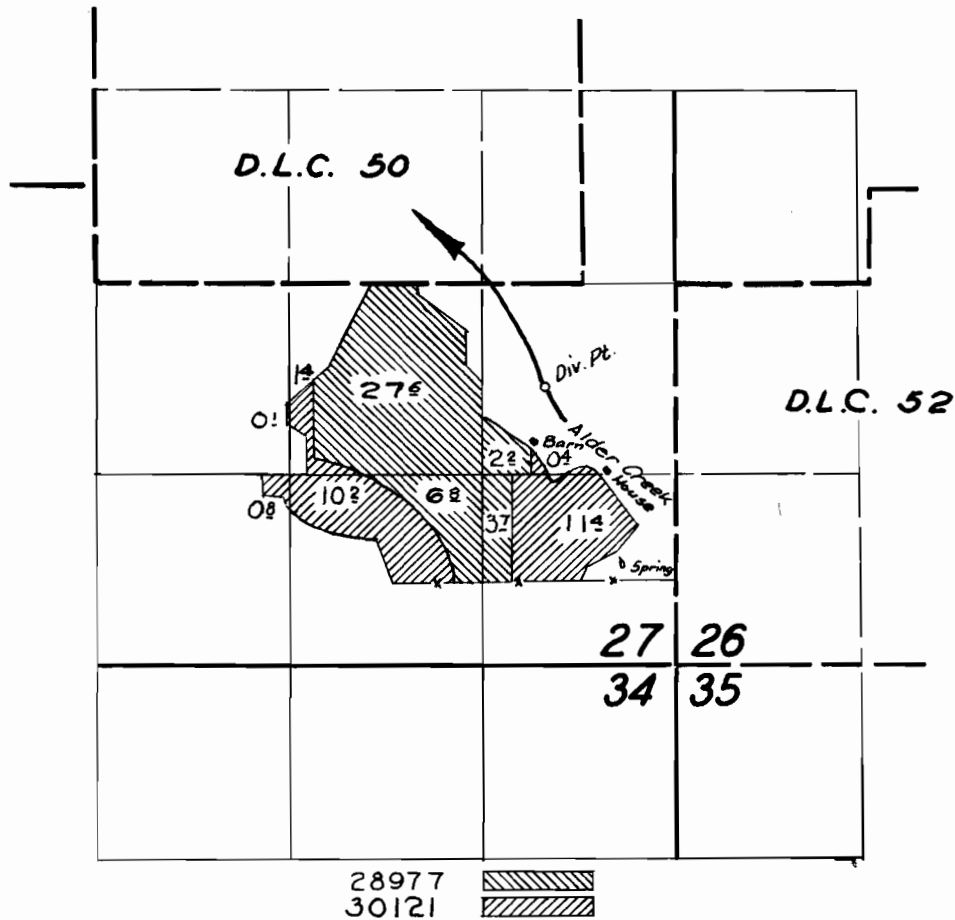

FINAL PROOF SURVEY
UNDER

28977 22785
Application No. 30121 Permit No. 23773
IN NAME OF

JOHN J. SCHMITZ

Surveyed 25 July 1959, by M. Bish

MB