


T.6S. R. 1E.W.M.

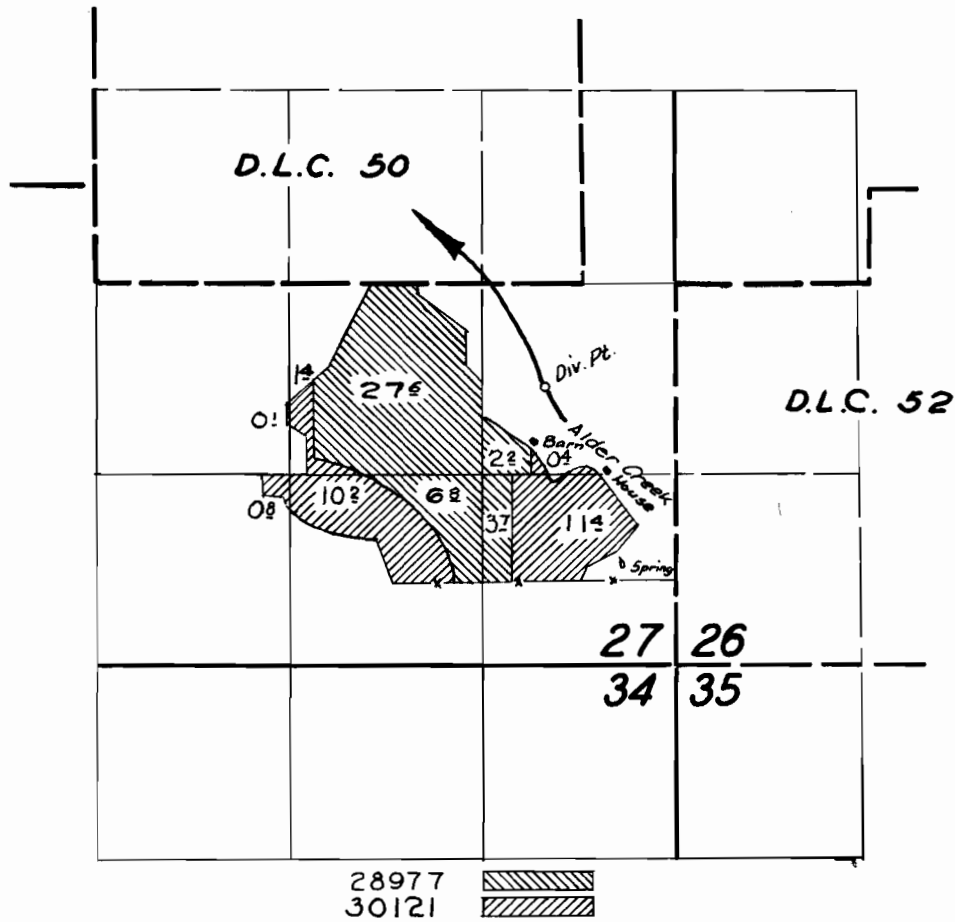

**FINAL PROOF SURVEY**  
UNDER

Application No. 28977 30121 Permit No. 22785 23773  
IN NAME OF

**JOHN J. SCHMITZ**

Surveyed 25 July 1959, by M. Bish

*MB*