


T.32S.R.5W.W.M.

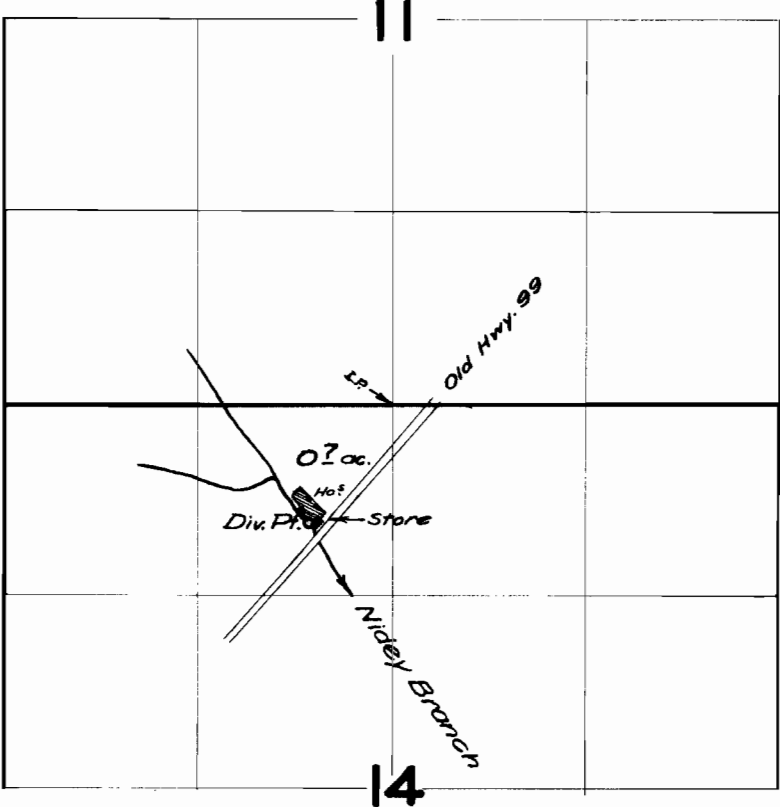

FINAL PROOF SURVEY
UNDER

Application No. 29026 Permit No. 22838
IN NAME OF

ELLIOTT & MODENE WOOLDRIDGE

Surveyed 6 Sept. 1958 by M. Bish