


T.33 S.R.6 W.W.M.

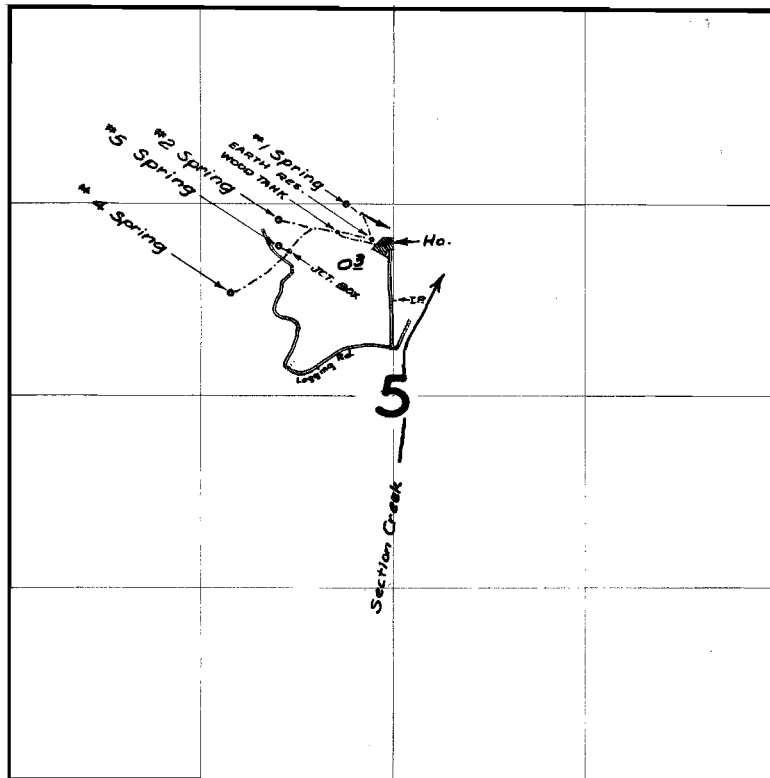

FINAL PROOF SURVEY
UNDER

Application No. 29159 Permit No. 22934
IN NAME OF

V. A. FARMER

Surveyed 3 Sept. 1958, by M. Bish