


T.9S. R.3 W.W.M.

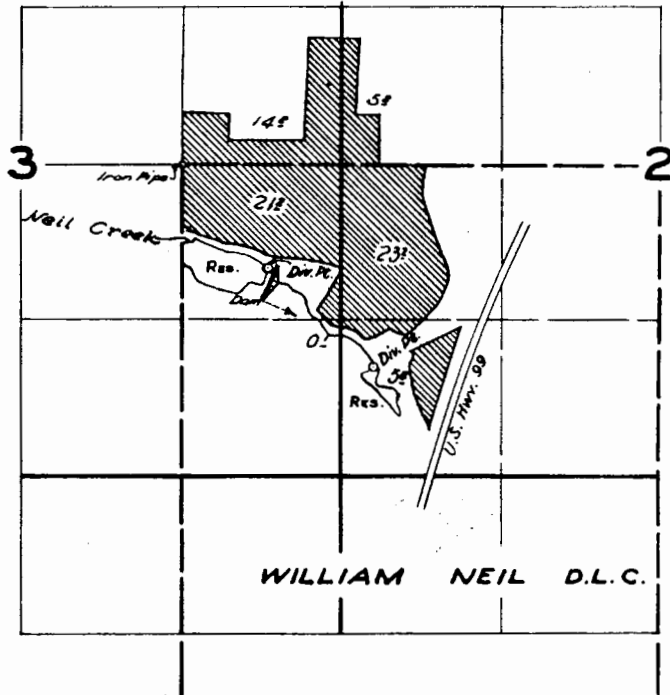

**FINAL PROOF SURVEY**  
UNDER

Application No. <sup>R-29302</sup> 29303. Permit No. <sup>R-1639</sup> 23031.  
IN NAME OF

**ASEL C. EOFF**

Surveyed 22 July 1959, by M. Bish

*MB*