


T.9S. R.3 W.W.M.

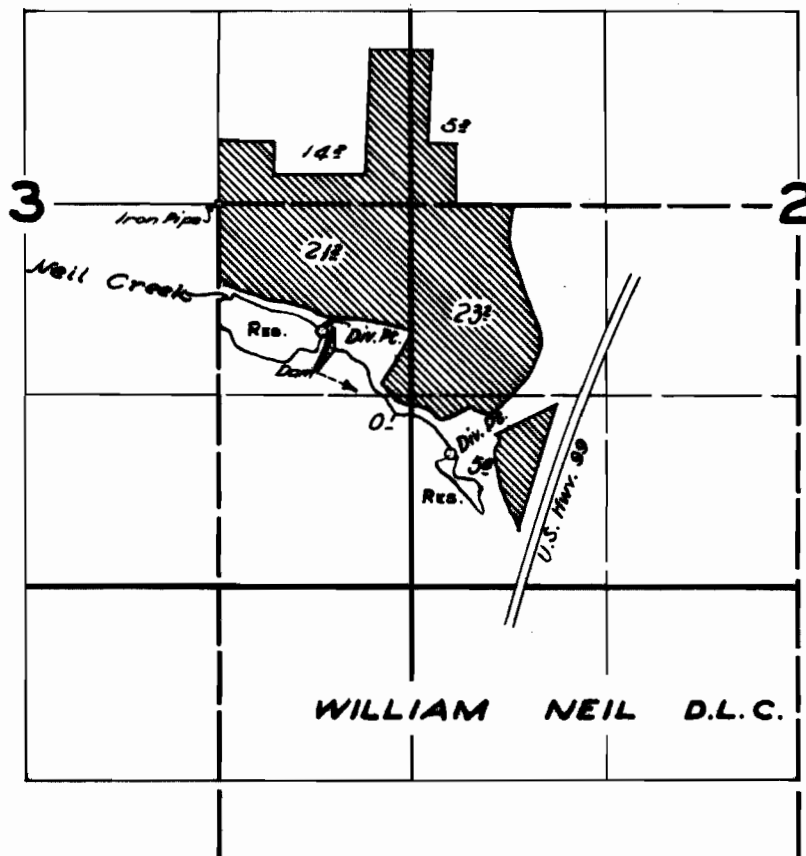

FINAL PROOF SURVEY UNDER

Application No. ^{R-29302}~~29303~~ Permit No. ^{R-1639}~~23031~~
IN NAME OF

ASEL C. EOFF

Surveyed *22 July* 1959, by *M. Bish*

EB