


T. 29 S. R. 33 E. W. M.

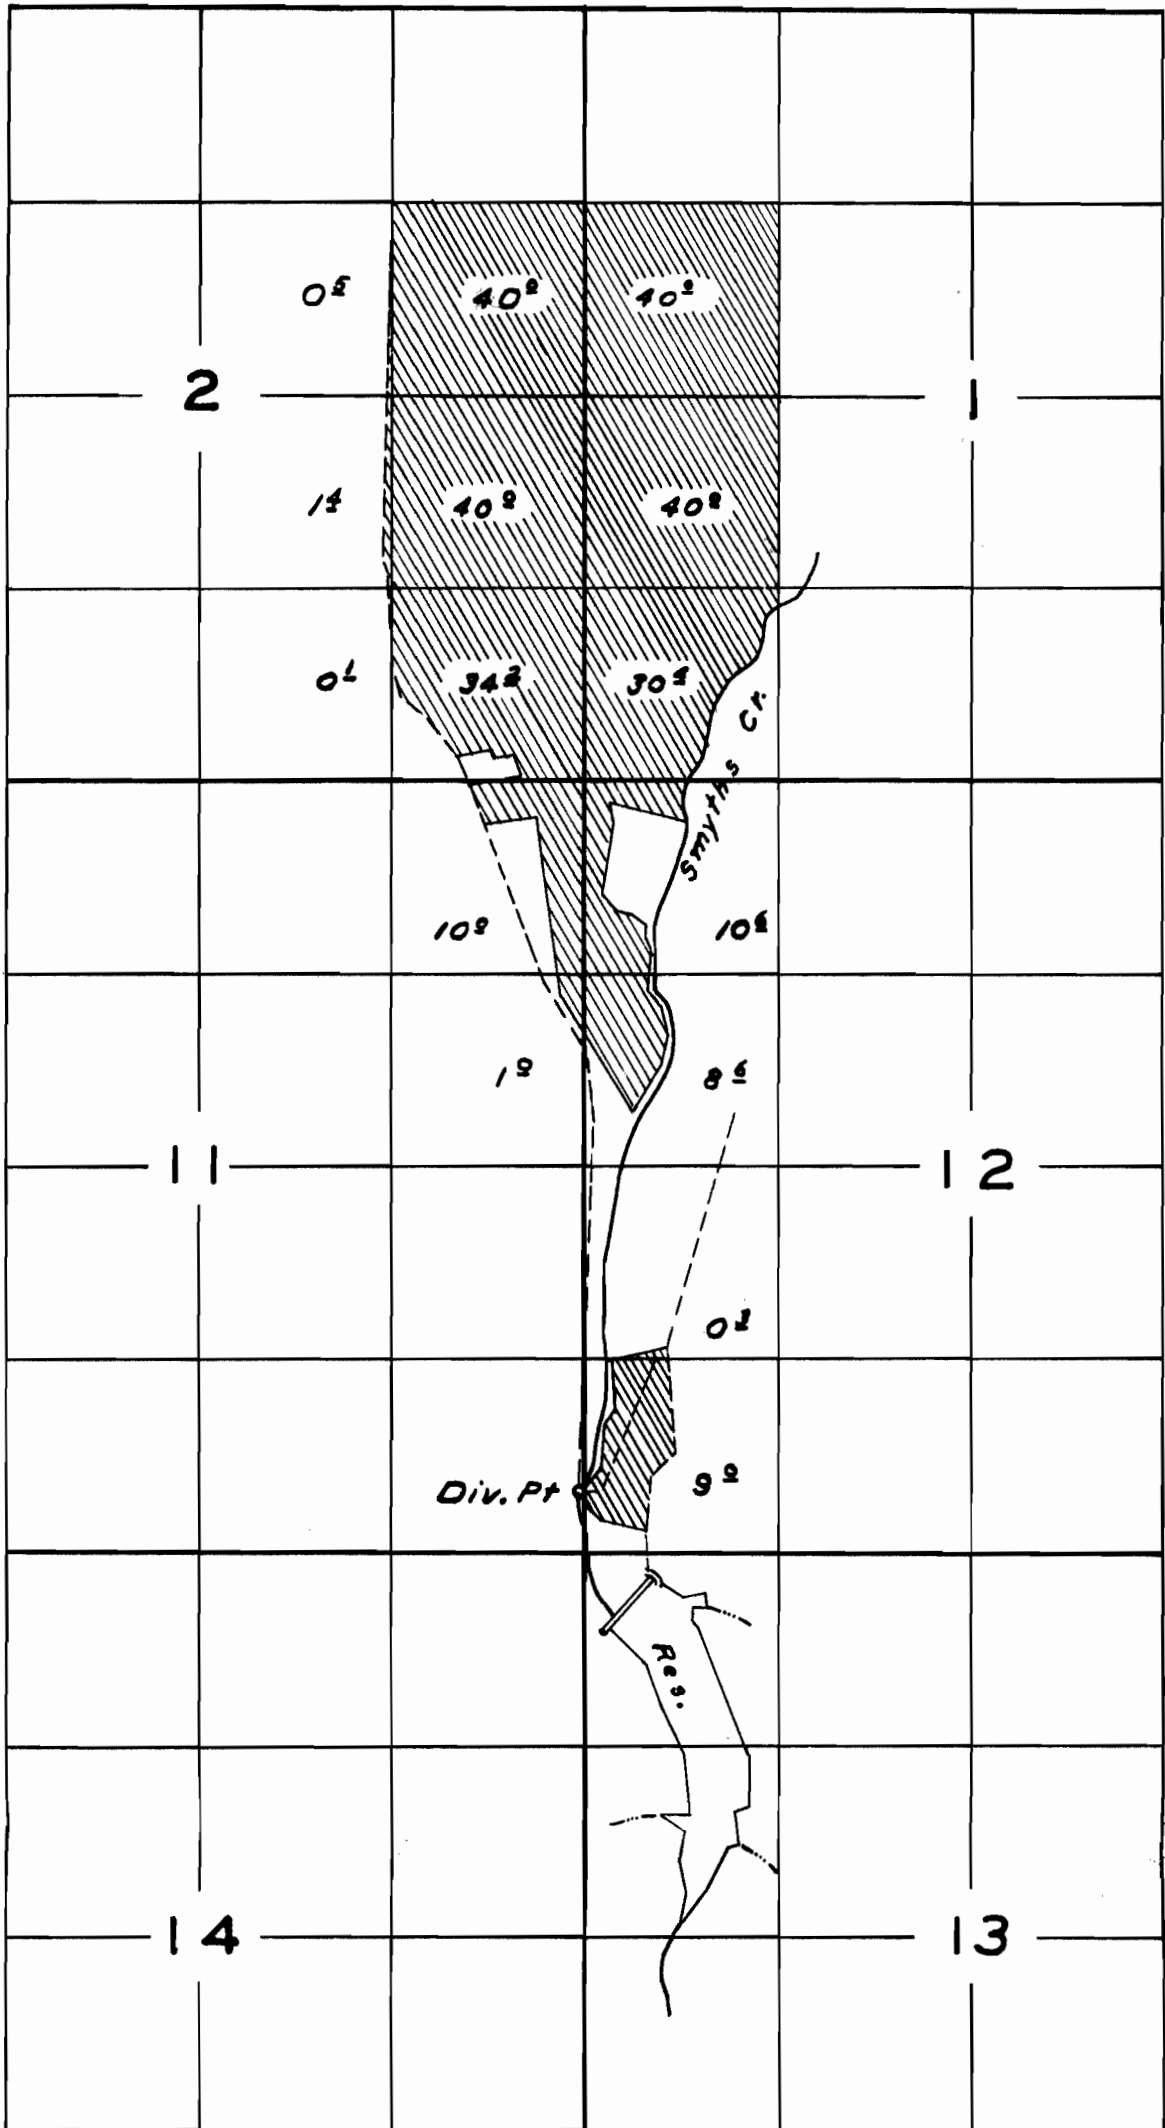

FINAL PROOF SURVEY
UNDER

APPL. NO. R-28545 PERMIT NO. R-1641
28546 IN NAME OF

D.H. & E.H. SMYTH

SURVEYED SEPT. 17 1958 BY W.N. PERRY