
T.30S.R.5 W.W.M.

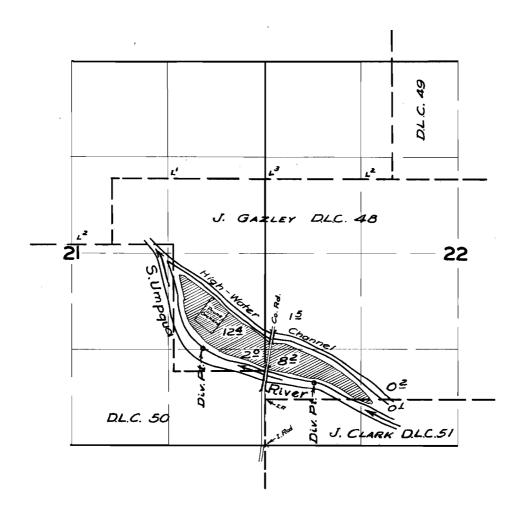

FINAL PROOF SURVEY

Application No. 29358 Permit No. 23/35 IN NAME OF
LAWRENCE J. BOYLE
Surveyed // Sept. 1958, by To Bil